THIS DOCUMENT AND ATTACHMENT(S) ARE AVAILABLE FOR DOWNLOAD AT <u>https://mrscrosters.bonfirehub.com/opportunities/179643</u> AN EMAIL NOTIFICATION WAS SENT TO REGISTERED DOCUMENT TAKERS. FAILURE TO ACKNOWLEDGE RECEIPT ON THE BID FORM DOES NOT AFFECT THE BIDDER'S OBLIGATION FOR COMPLIANCE.



ADDENDUM NO. 1

WASHINGTON STATE PARKS AND RECREATION COMMISSION POTHOLES STATE PARK SEWER LIFT STATION REPLACEMENT EW-C6701

DATE: March 31, 2025

ATTENTION TO PLANHOLDERS OF RECORD. The following revisions are hereby made a part of the Contract Documents. *Please be sure to acknowledge all Addenda on the Bid Form.*

CHANGES TO THE DRAWINGS

- The posted drawing set has been revised.
- On the original **Cover Sheet**, an error was discovered in the Index. The revised drawing set has the cover page with the correct index.

Action Required:

Please remove the original drawing set in its entirety and replace it with the attached revised set, which includes **Sheets 1-20**.

ATTACHMENTS.

— Complete Drawing Set-Revised (20 pages)

For questions or further clarification, please contact State Parks Representative David Brown at (509) 665-4338, <u>david.crown@parks.wa.gov</u>.

Brett Taylor

03/31/25 Date

Brett Taylor, Procurement Coordinator Contracts and Grants Program

END OF ADDENDUM NO. 1


WASHINGTON STATE PARKS & RECREATION COMMISSION

KEN BOUNDS, CHAIR

SOPHIA DANENBERG LAURIE CONNELLY MARK O. BROWN

DIANA DUPUIS, DIRECTOR

POTHOLES STATE PARK SEWER LIFT STATION REPLACEMENT

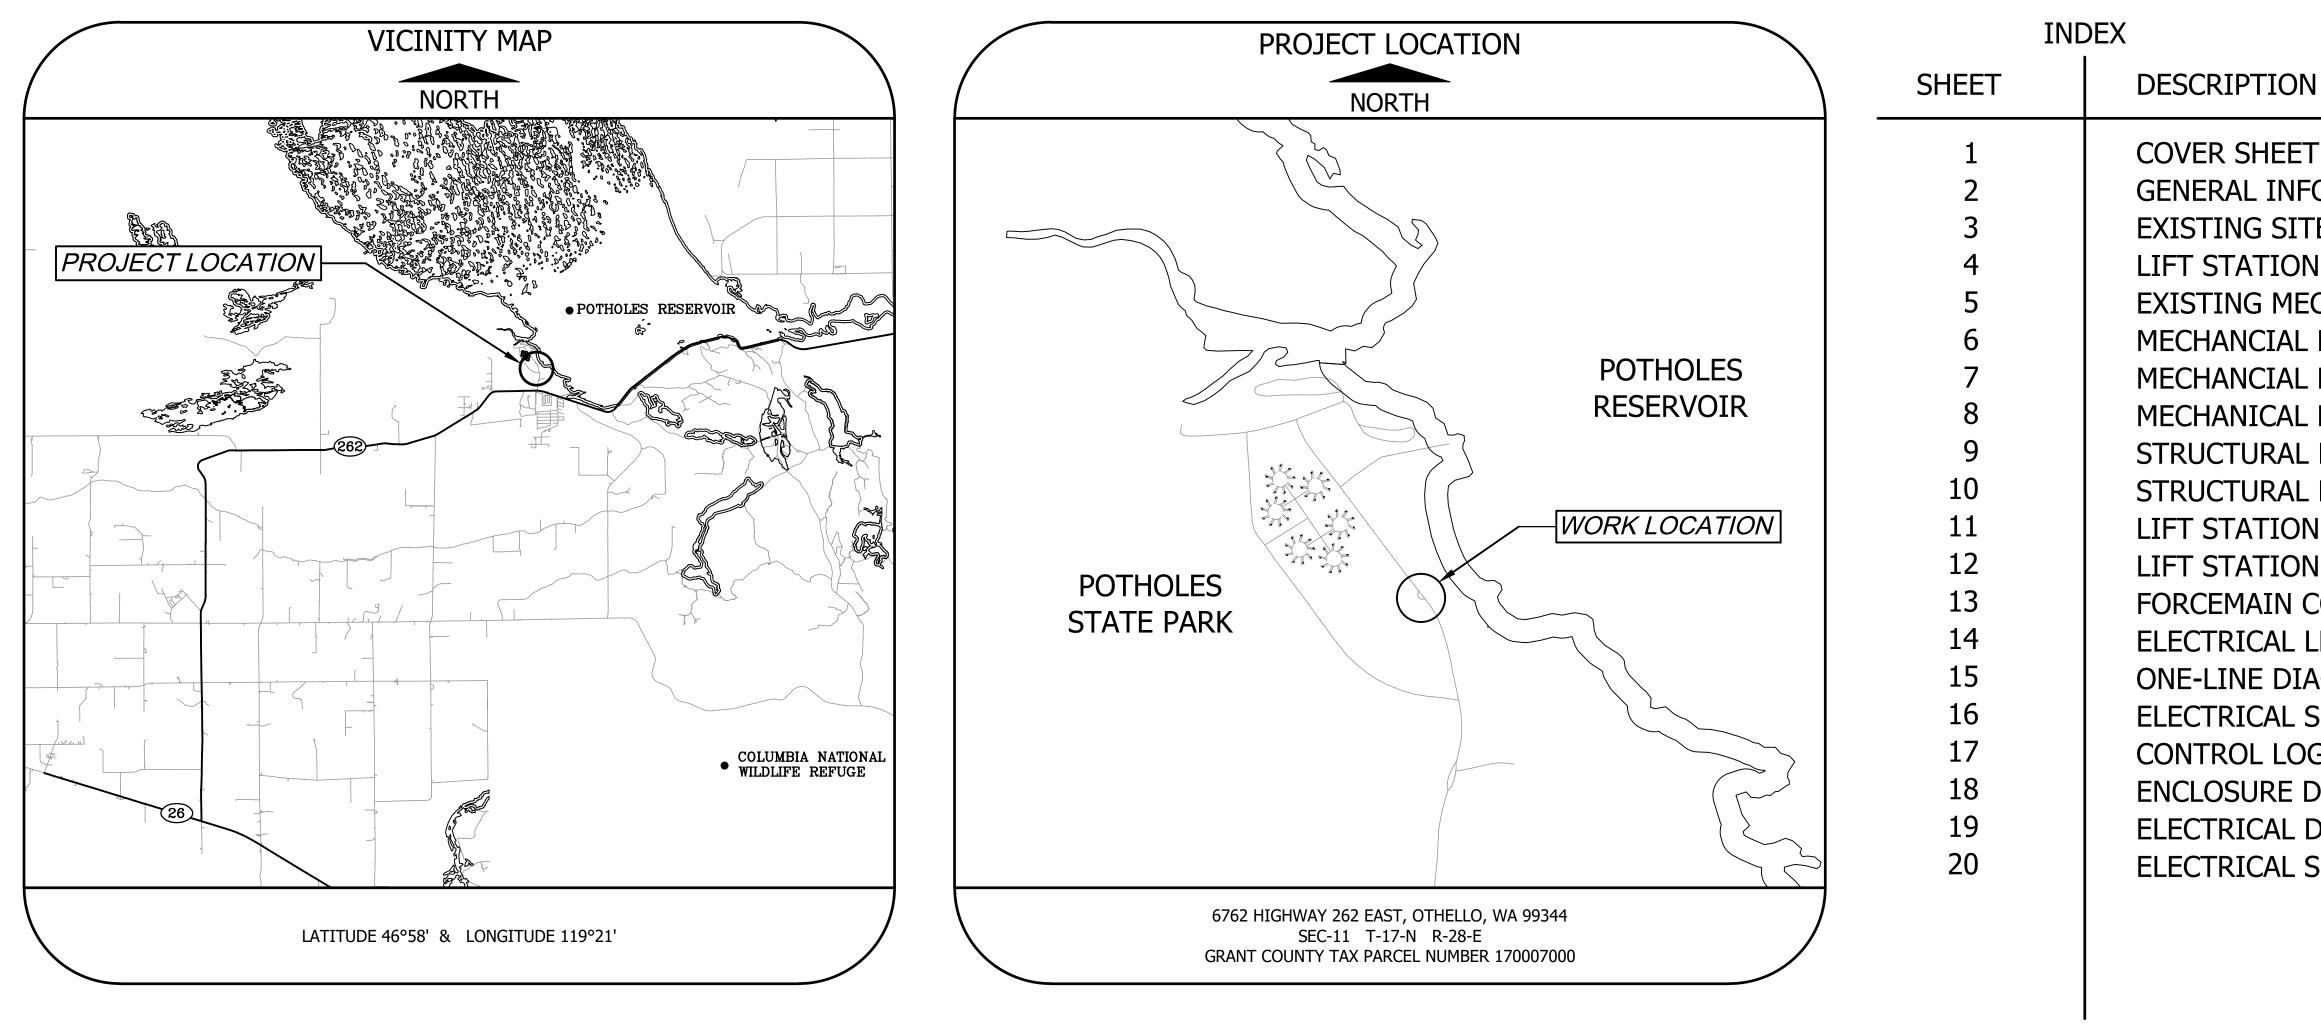

MICHAEL LATIMER HOLLY WILLIAMS ALI RAAD



Area Manager: Denis Felton

rson Both 2/20/202 , 2/20/2025

GENERAL INFORMATION EXISTING SITE PLAN LIFT STATION SITE PLAN EXISTING MECHANICAL AND DEMOLITION PLAN MECHANCIAL PLAN 1 MECHANCIAL PLAN 2 MECHANICAL DETAILS STRUCTURAL PLAN 1 STRUCTURAL ELEVATIONS AND PLAN LIFT STATION DETAILS 1 LIFT STATION DETAILS 2 FORCEMAIN CONNECTION DETAIL ELECTRICAL LEGEND ONE-LINE DIAGRAM ELECTRICAL SITE PLAN CONTROL LOGIC DIAGRAM **ENCLOSURE DETAILS** ELECTRICAL DETAILS ELECTRICAL SCHEDULES

LEGEND


s	EXISTING GRAVITY SEWER
	ABANDONED GRAVITY SEWER
F	EXISTING SEWER FORCE MAIN
	ABANDONED SEWER FORCE MAIN
~~~~~~~~~~~~~~~~~~~~~~~~~~~~~~~~~~~~~~	ABANDONED UGP
w	EXISTING DOMESTIC WATER
——— <i>I/W</i> ———	EXISTING IRRIGATION
— — – UGP - — —	EXISTING UNDERGROUND ELECTRICAL (SECONDARY)
——-[ <u>U</u> GP]-——	EXISTING UNDERGROUND ELECTRICAL (PRIMARY)
	EXISTING ELECTRICAL TRANSFORMER
$\diamond$	EXISTING IRRIGATION BOX
$\otimes$	EXISTING IRRIGATION VALVE
	EXISTING DRAIN VALVE
0	EXISTING SPRINKLER
$(\circ)$	EXISTING TREE
	EXISTING VEGETATION
	MATERIAL AND EQUIPMENT STORAGE AREA
r	EXISTING PAVEMENT AND CONCRETE
<b></b>	CONSTRUCTION DISTURBANCE LIMITS
	EXCAVATION LIMITS
UGP	UNDERGROUND POWER
G <del>- 0- 0</del>	TREE PROTECTION FENCE
$\Delta$	YARD HYDRANT DRAIN VALVE
— <del>X</del> ——	SILT FENCE

—×——— CHAINLINK FENCE

#### CONSTRUCTION NOTES


- 1. EXISTING SITE PLANS WERE DEVELOPED FROM MULTIPLE PRIOR PROJECT RECORDS. NO SURVEY WAS PERFORMED FOR THIS PROJECT. TOPOLOGICAL AND UTILITY INFORMATION SHOWN MAY NOT ACCURATELY REFLECT EXISTING CONDITIONS. CONTRACTOR SHALL NOTIFY THE OWNER IMMEDIATELY IF FIELD CONDITIONS VARY FROM THOSE SHOWN.
- 2. SLOPED-SIDE EXCAVATION IN LIEU OF SHORING FOR WETWELLS WILL NOT BE ALLOWED. SHORING MANHOLE BOXES, MANHOLE SHIELDS OR FUNCTIONAL EQUIVALENT MUST BE USED FOR CONSTRUCTION OF THE WET WELLS.

NO	TES:
1.	FILTER FABRIC F
	ALONG CONTOU
2.	SILT FENCE SHAI WORK IS BEING PERPENDICULAR

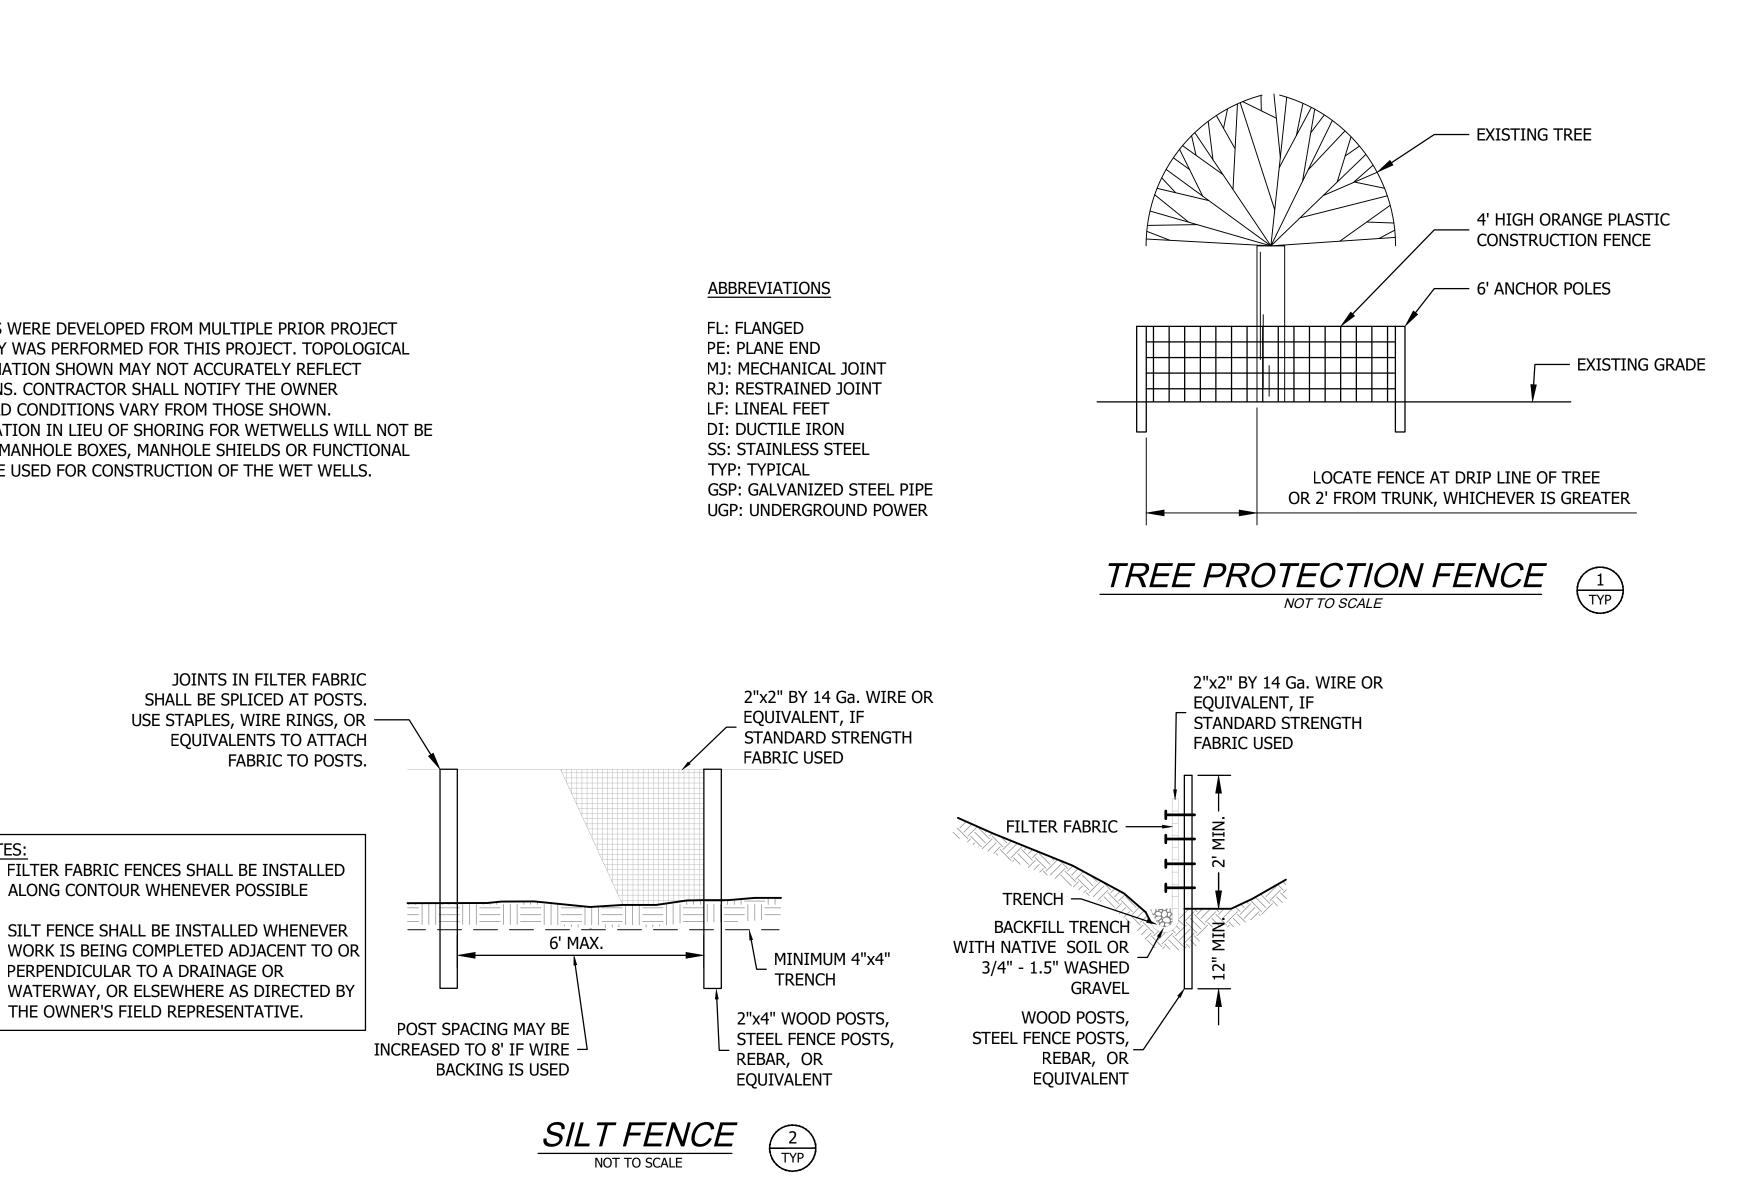


RH2


CAD NO. psp-p-ov	INT. APP. DATE
	REVISIONS
ACTIONBYDATDESIGNEDPNY1/27/2DRAWNJTR1/27/2CHECKED (FIELD)-CHECKED (HDQTS.)-	025
SIGNED: 01/27/2025 PROJECT ENGINEER	
WASHINGTON STATE PARKS AND RECREATION COMMISSION	
POTHOLES STATE PARK SEWER LIFT STATION REPLACEMENT	
GENERAL INFORMATION	N
SHEET 2 OF 20	

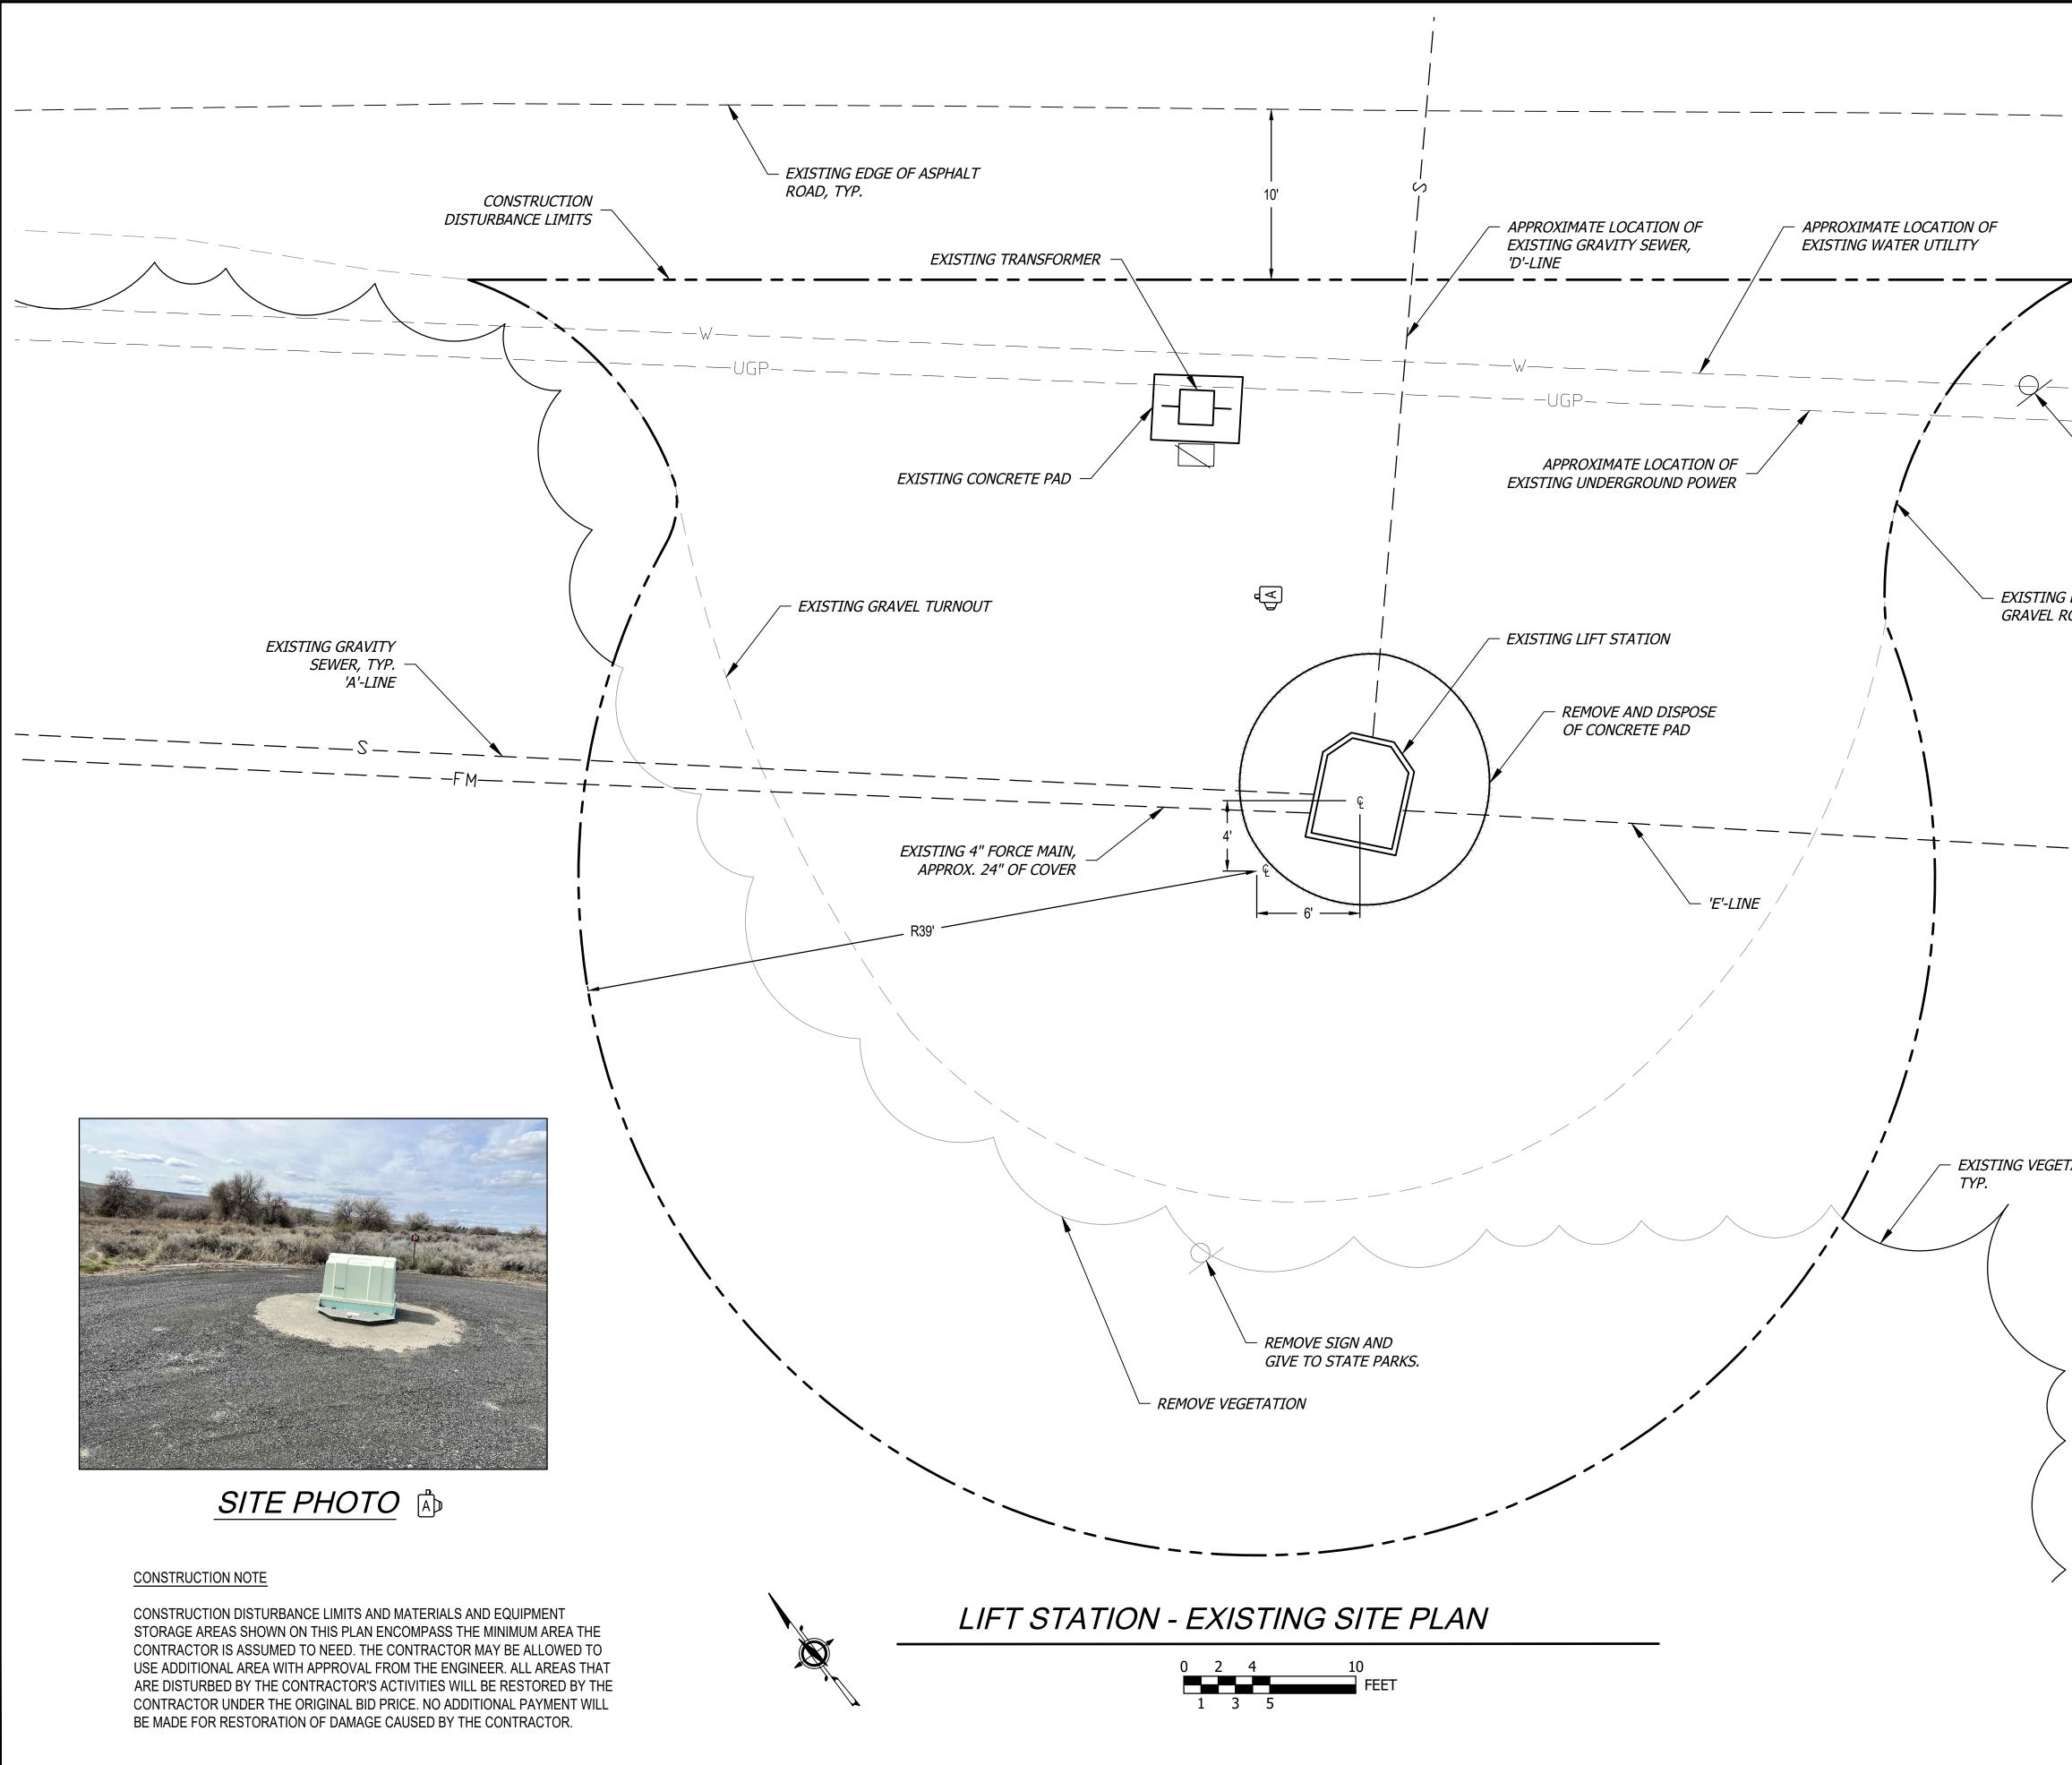


	CAD NO. psp-p-esite	
		Ш
		DATE
		APP.
		INT.
		6
		REVISIONS
		REVJ
$\overline{}$		
└─ EXISTING SIGN		
		NO.
	ACTION BY DATE DESIGNED PNY 1/27/20	
EDGE OF	DRAWN JTR 1/27/20	
ROAD, TYP.	CHECKED (FIELD) CHECKED (HDQTS.)	
	NATHAN	
- — —	53379	
	SIGNED OF ON OUR	
	<i>SIGNED: 01/27/2025</i> PROJECT ENGINEER	
	WASHINGTON	
	STATE WASHINGTON	
	PARKS	
	AND State PARMES	
TATION,	RECREATION	
	COMMISSION	
	POTHOLES	
	STATE PARK	
	SEWER LIFT STATION REPLACEMENT	
<b>,</b>		
	EXISTING SITE PLAN	
RH2	SHEET 3 OF 20	

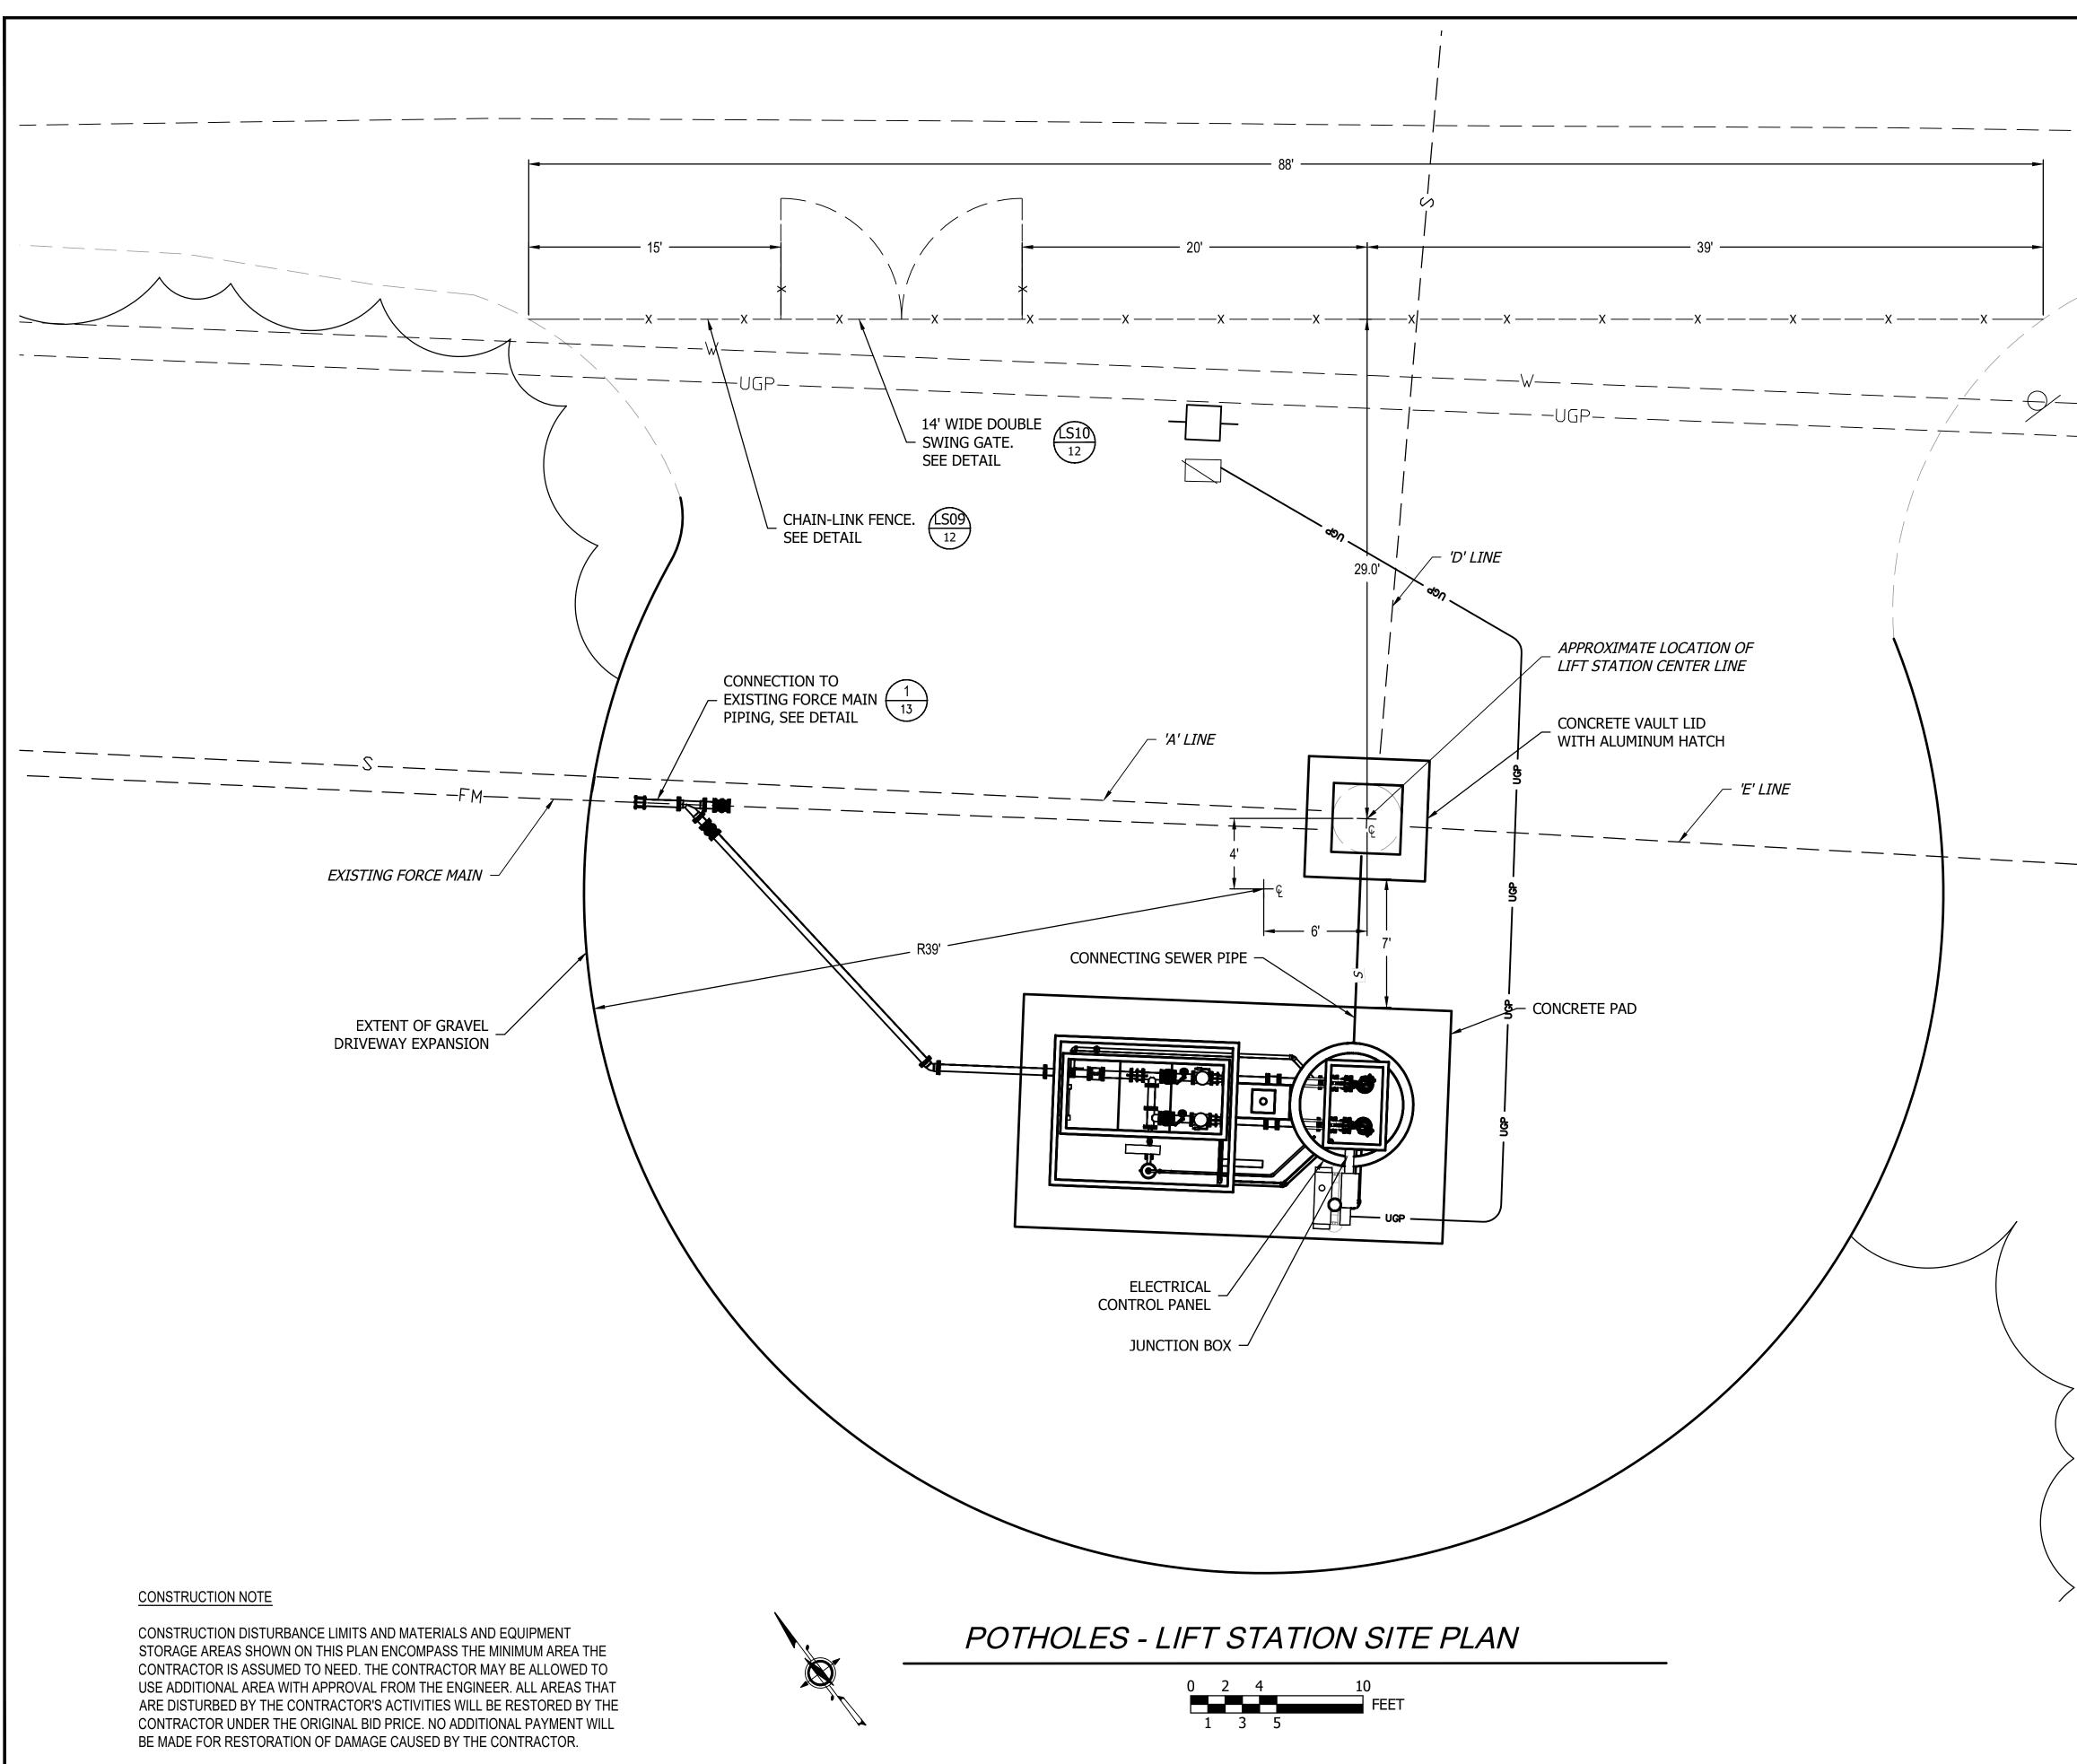


	CAD NO. psp-p-psite	Π
		DATE
		APP.
		INT.
		NS
		REVISIONS
		RE
	ACTION BY DATE	ON F
	DESIGNED PNY 1/27/20	)25
	DRAWN JTR 1/27/20 CHECKED (FIELD)	)25
	CHECKED (HDQTS.)	_
	NN THAN OF WASHING	
—S— — — _		
	TOP IS INT THE ISLAND	
	<i>SIGNED: 01/27/2025</i> PROJECT ENGINEER	
	WASHINGTON	
	STATE WASHINGTON	
	PARKS	
	AND STORE PARMS	
	RECREATION	
	COMMISSION	
	POTHOLES	$\neg$
	STATE PARK	
	SEWER LIFT STATION REPLACEMENT	
		-
	LIFT STATION SITE PLAN	N
RH2	SHEET 4 OF 20	

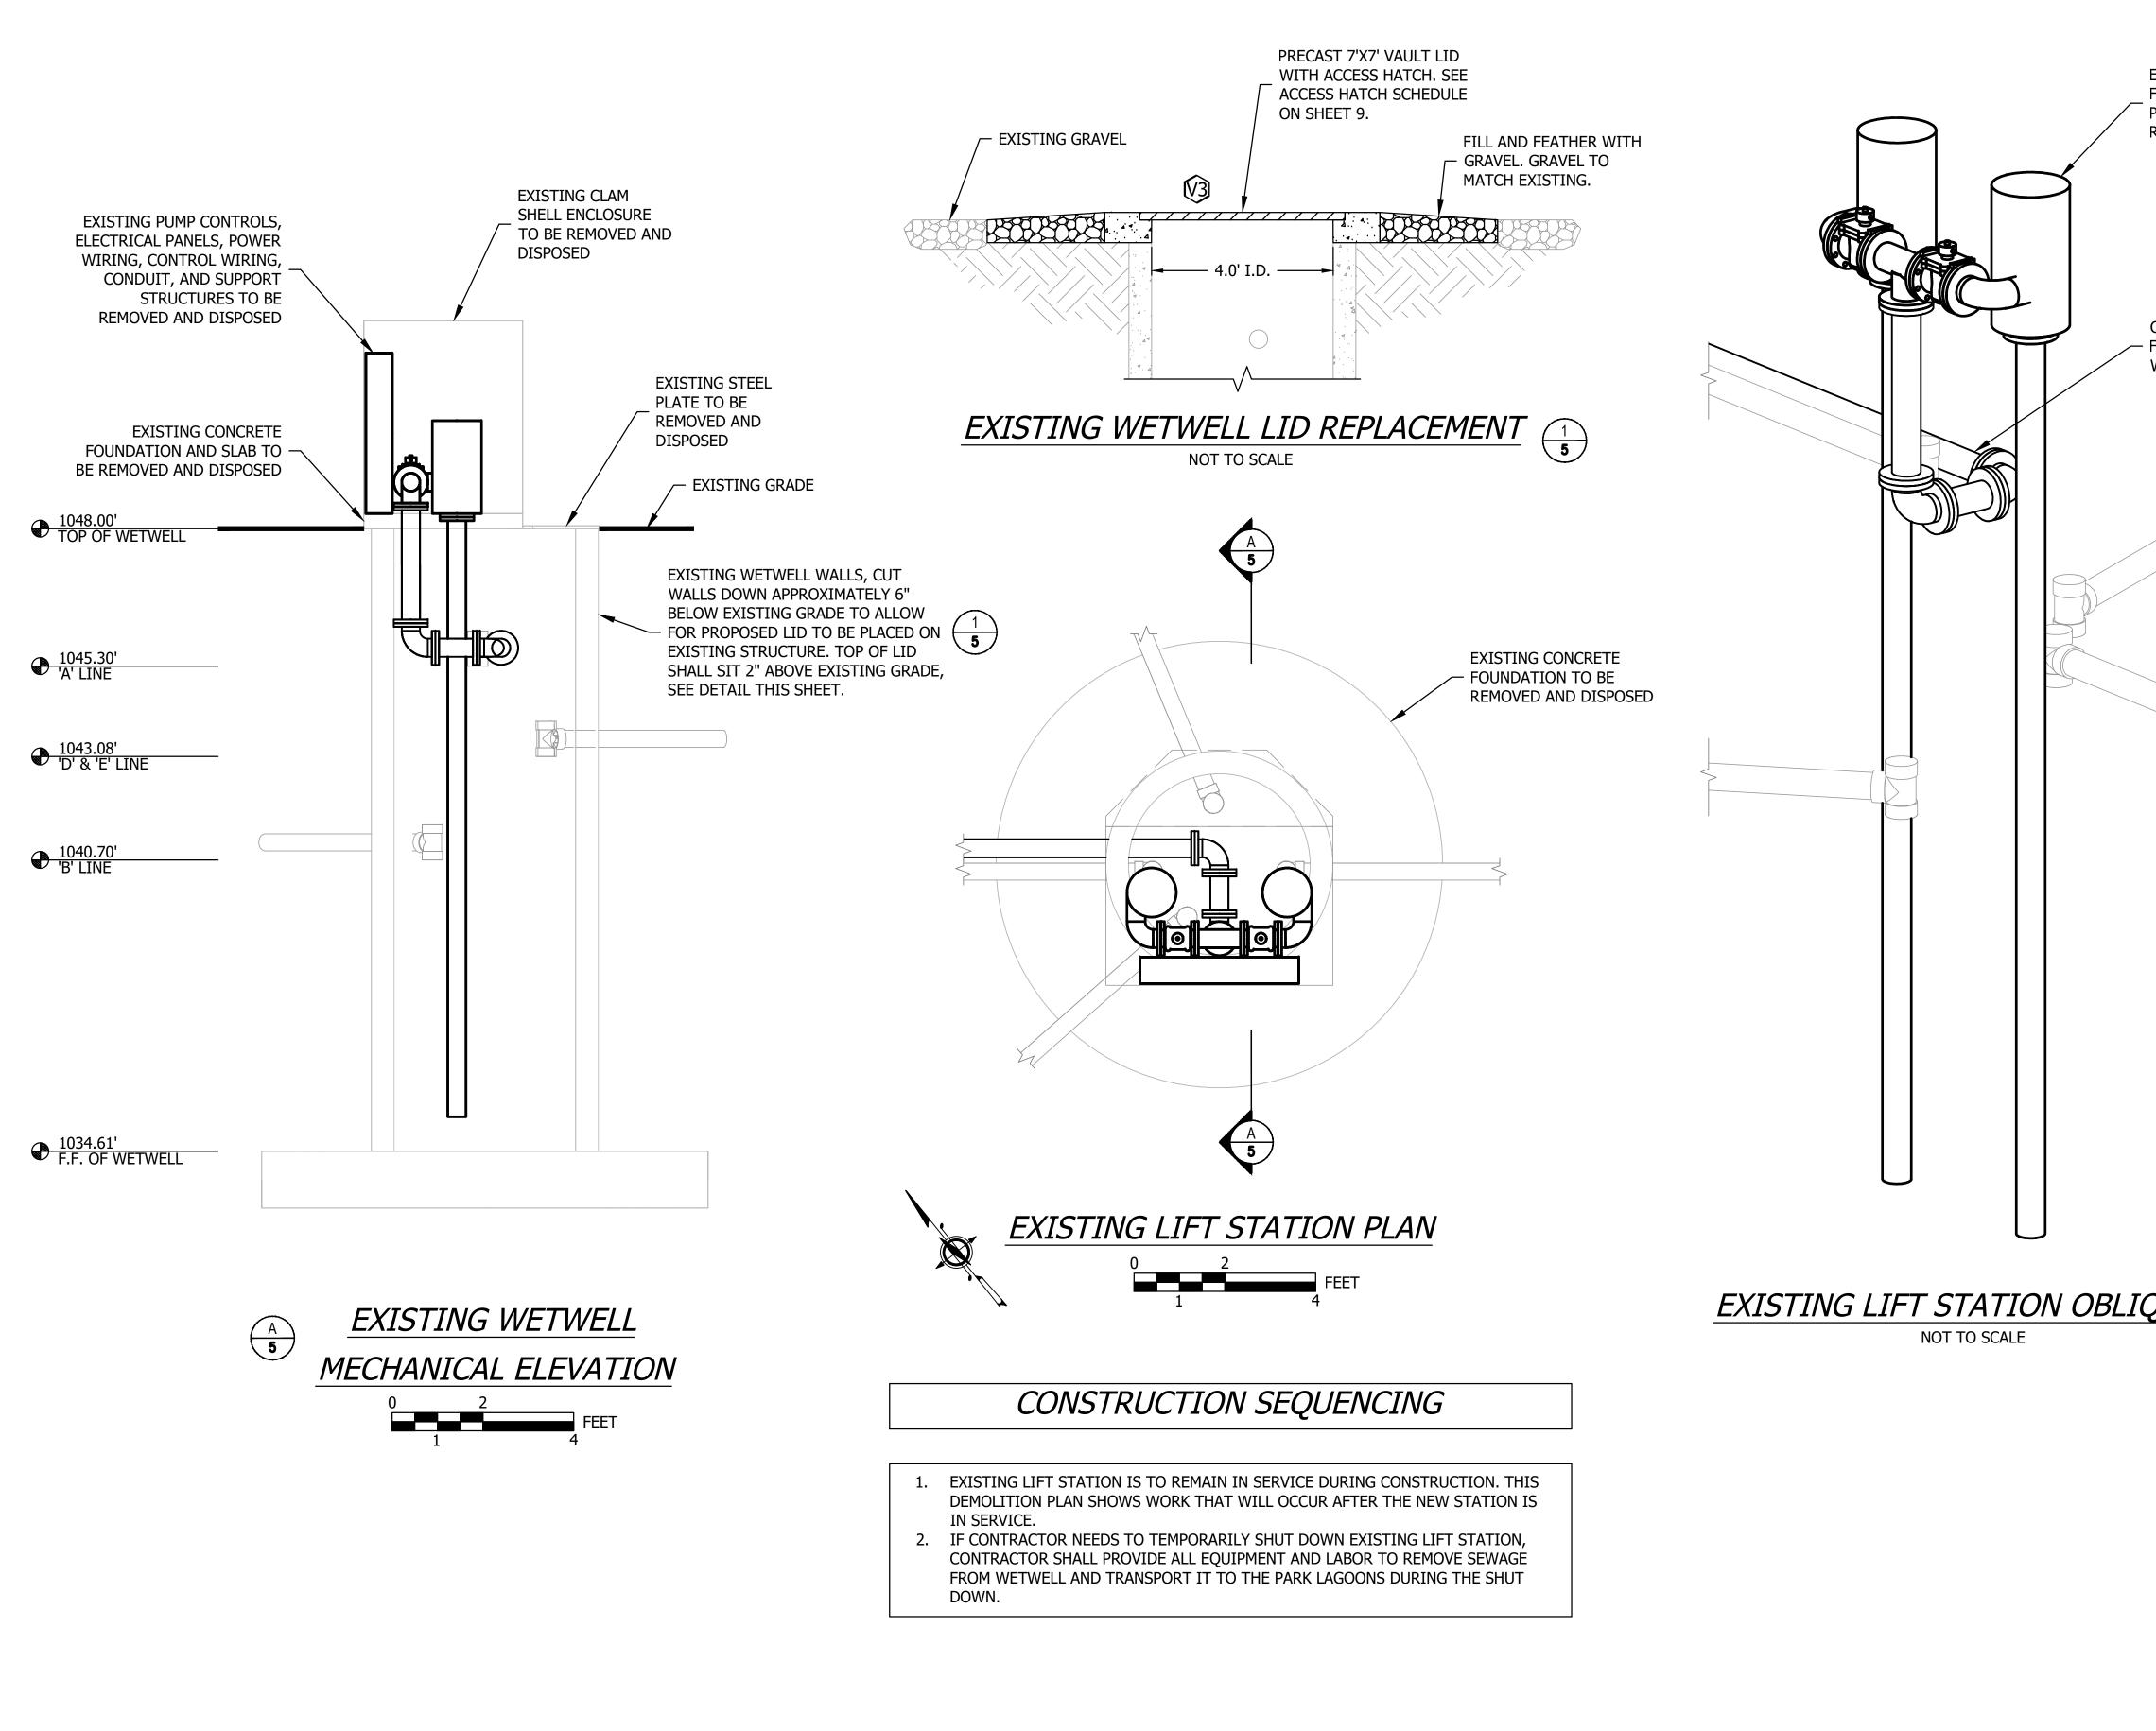



	CAD NO. PSP-P-MECH
	DATE
	APP.
EXISTING PUMPS,	INT.
FITTINGS, FORCEMAIN PIPING, AND VALVES TO BE	
REMOVED AND DISPOSED	
	SNC
	REVISIONS
CUT FORCEMAIN PIPE	
FLUSH WITH WETWELL WALL AND GROUT OPENING	
	Q
	ACTION BY DATE DESIGNED PNY 1/27/2025
	DESIGNEDINII/27/2023DRAWNJTR1/27/2025CHECKED (FIELD)
	CHECKED (HDQTS.)
INLET PIPES TO REMAIN (TYP. 4)	
	VATHAN OF WASHING
	TOPRESIST REP. NUT
	<i>SIGNED: 01/27/2025</i> PROJECT ENGINEER
	WASHINGTON
	STATE WASHINGTON
	PARKS
	AND STATE PARTYS
	RECREATION
	COMMISSION
	POTHOLES
	STATE PARK
QUE	SEWER LIFT STATION REPLACEMENT
	KEPLACEMENT
	EXISTING MECHANICAL AND DEMOLITION PLAN
RH2	
	SHEET 5 OF 20

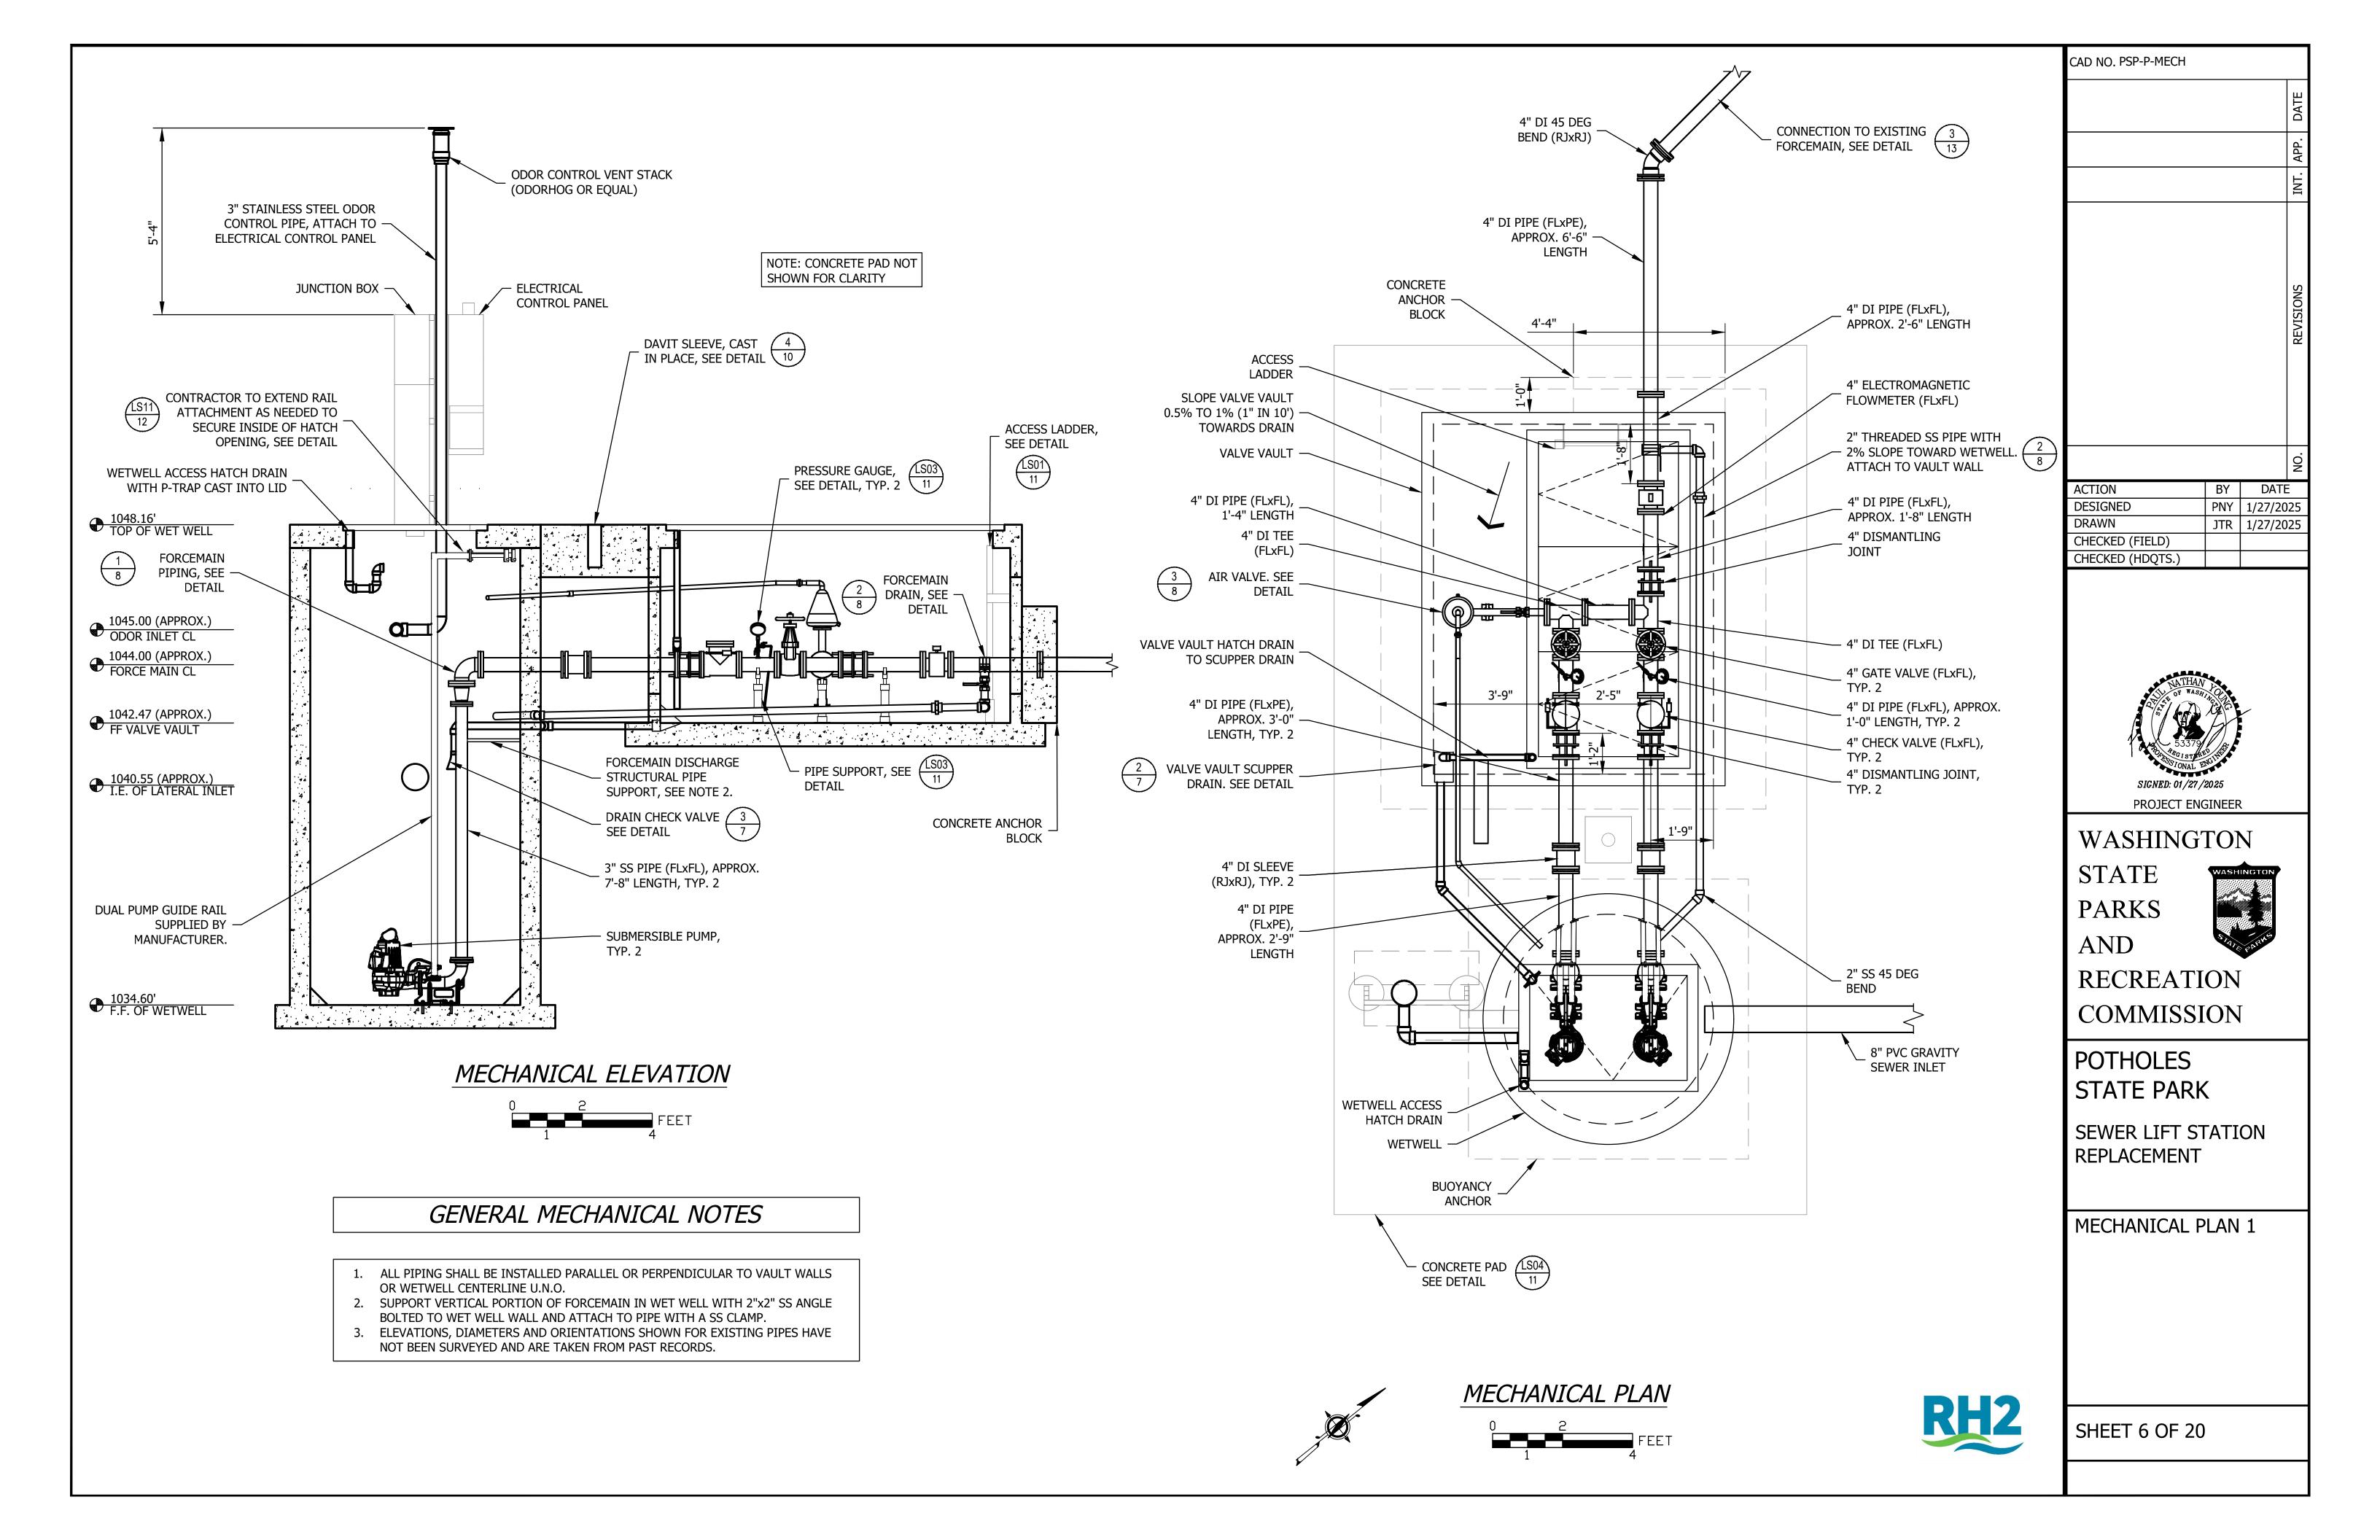

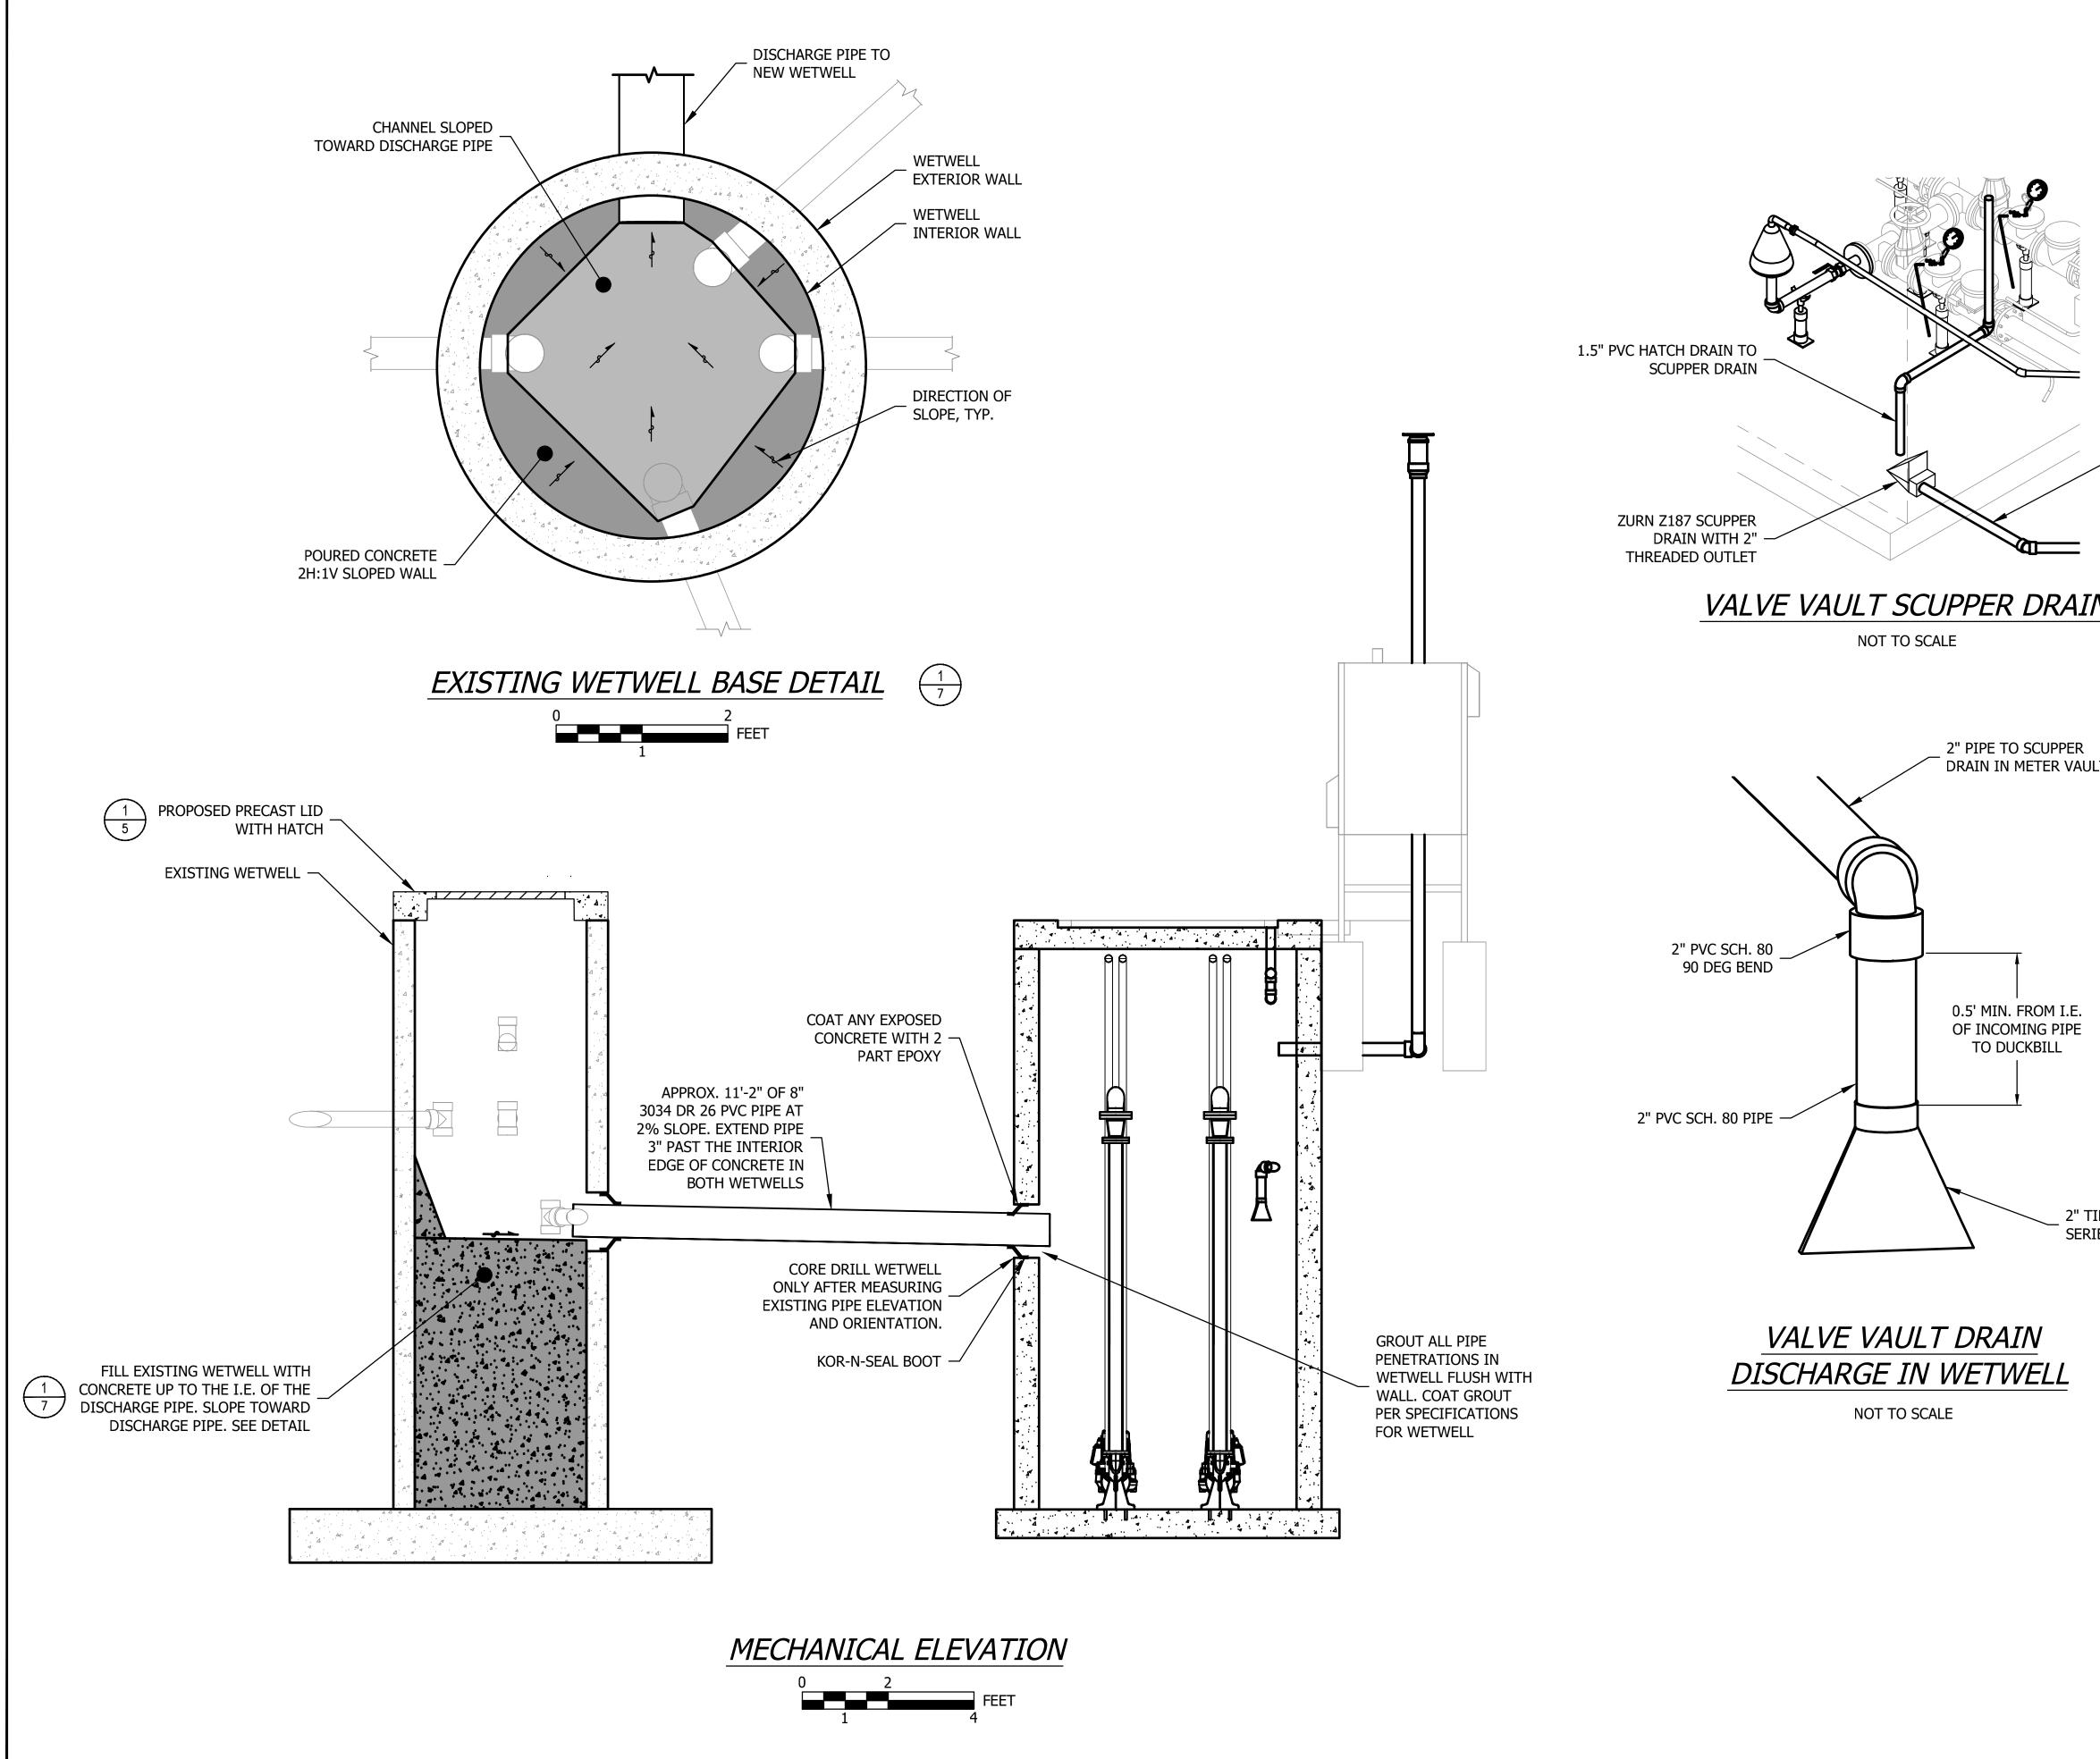



	CAD NO. PSP-P-MECH
	DATE
	APP.
	INT.
	N
	REVISIONS
	REVI
2" SCUPPER DRAIN PIPE TO WETWELL	
	N
	ACTION BY DATE
	DESIGNED         PNY         1/27/2025           DRAWN         JTR         1/27/2025
$\underline{N}$ $\underline{2}$	CHECKED (FIELD) CHECKED (HDQTS.)
6	
ILT	The second se
	A LINE WASHING
	PEGISTINE NONAL ENCINE
	SIGNED: 01/27/2025
	PROJECT ENGINEER
	WASHINGTON
	STATE WASHINGTON
	PARKS
	AND STORE PARMES
	RECREATION
	COMMISSION
IDEFLEX DUCKBILL IES TF-2	POTHOLES
	STATE PARK
	SEWER LIFT STATION REPLACEMENT
6	
	MECHANICAL PLAN 2
RH2	
	SHEET 7 OF 20

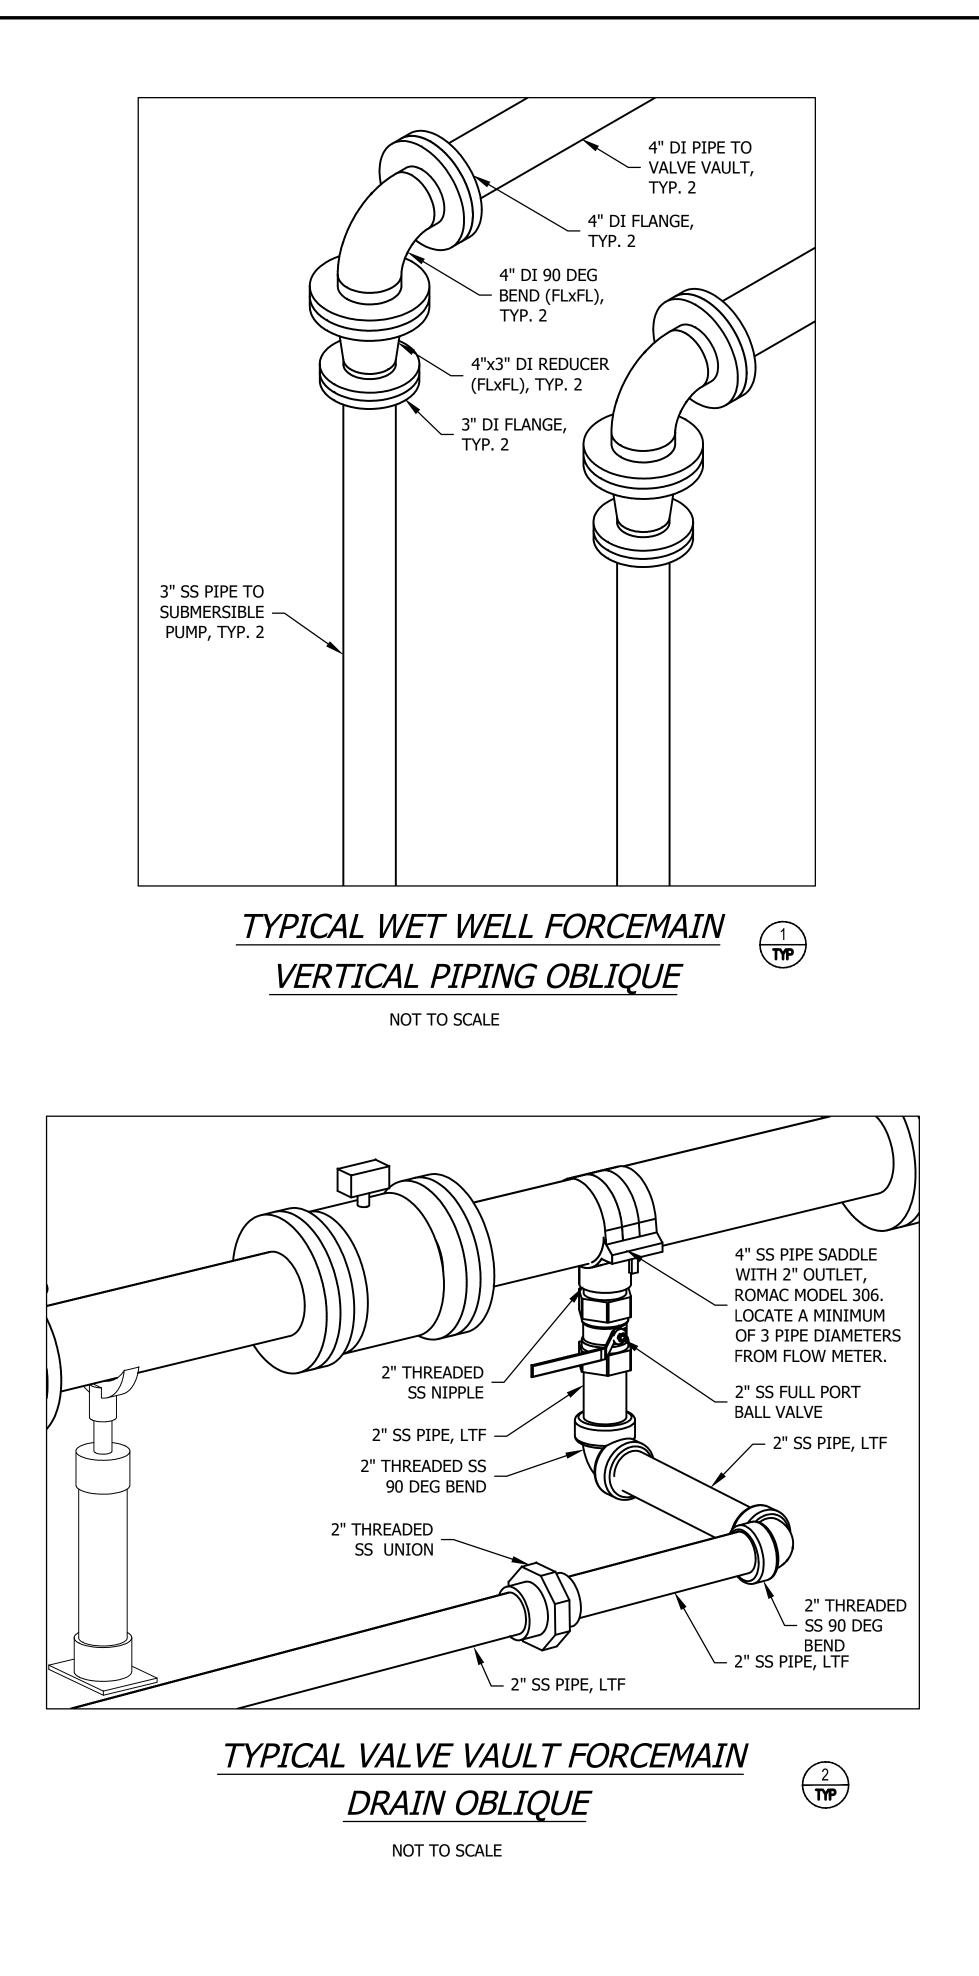

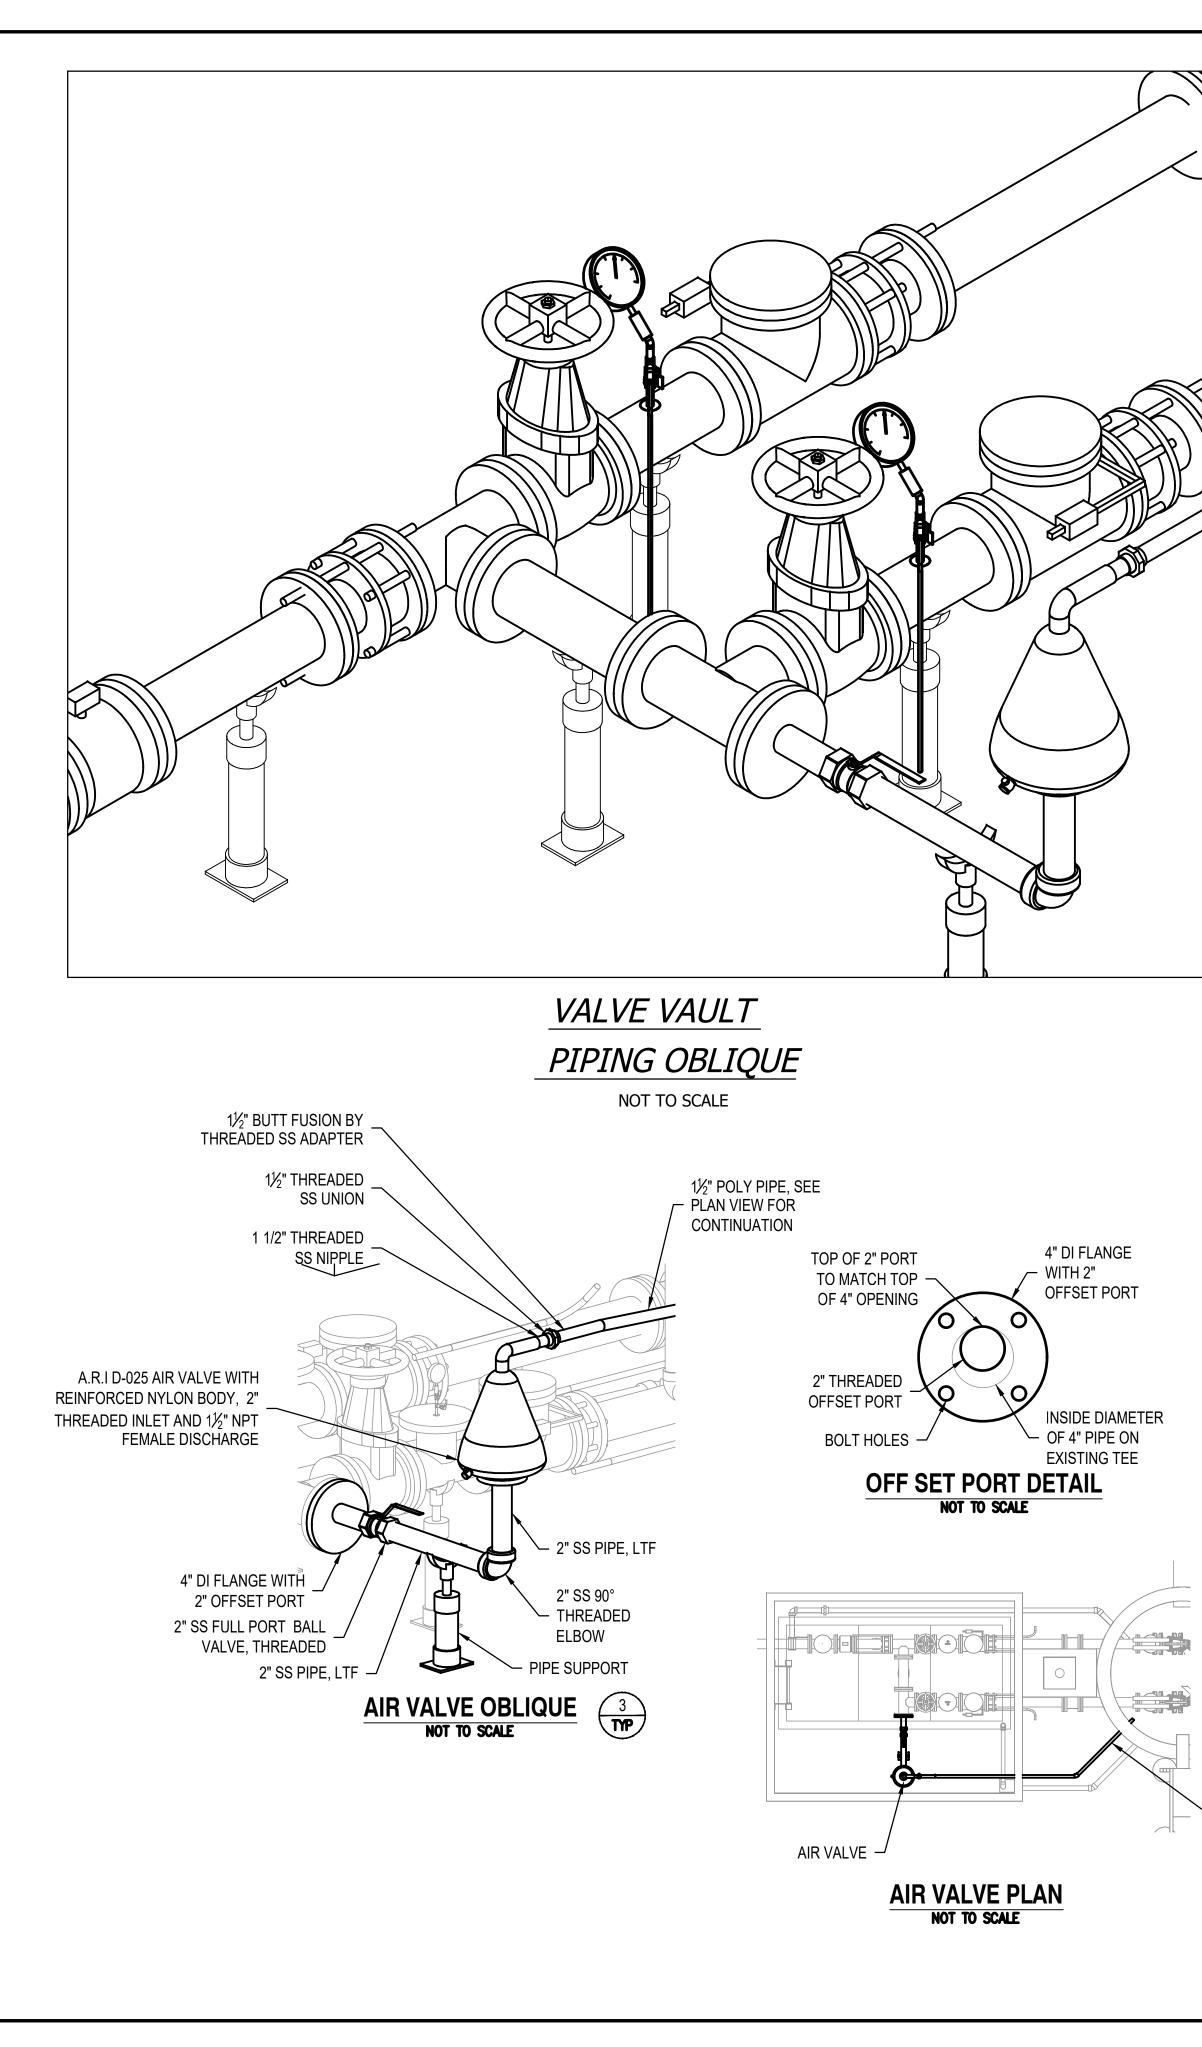

	CAD NO. PSP-P-MECH
	DATE
	APP.
	INI I
	S
	REVISIONS
5	
	ġ
	ACTION BY DATE
	DESIGNED         PNY         1/27/2025           DRAWN         JTR         1/27/2025           CHECKED (FIELD)
	CHECKED (HDQTS.)
	VASHINGTON STATE PARKS AND RECREATION COMMISSION POTHOLES STATE PARK SEWER LIFT STATION PEPI ACEMENT
	REPLACEMENT
	MECHANICAL DETAILS
VENT DISCHARGE PIPING INTO WETWELL. SLOPE PIPE FROM AIR VALVE TO WETWELL	
RH2	SHEET 8 OF 20

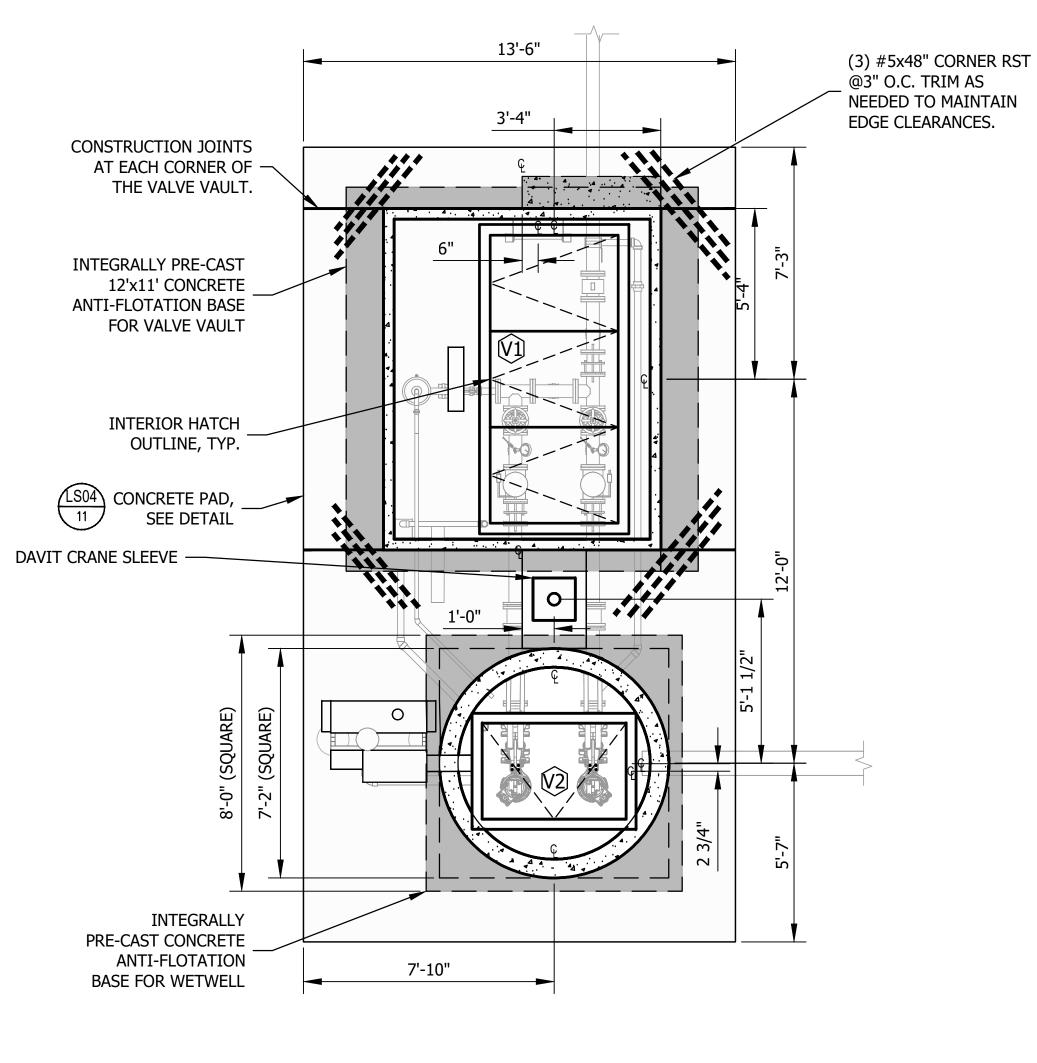


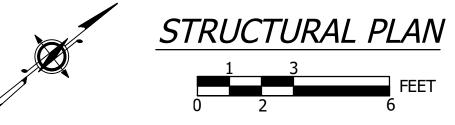

	ACCESS HATCH SCHEDULE						
ID NO.	CLEAR OPENING	NO. OF LEAVES	MATERIAL	RATING	MOUNTING	SAFETY GRATING	GASKET
V1	48" X 108"	3	ALUMINUM	300 LBS/SF	EMBEDDED	NO	STANDARD
<u>(</u> 2	54" X 36"	1	ALUMINUM	300 LBS/SF	EMBEDDED	YES	ODOR TIGHT
<del>V3</del>	48" X 48"	2	ALUMINUM	H-20	EMBEDDED	NO	ODOR TIGHT


# HATCH NOTES

- SEE SPECIFICATIONS FOR ADDITIONAL INFORMATION. 1.
- 2. WETWELL HATCH FRAME TO BE MODIFIED FOR PUMP CABLE REMOVAL. DEBUR AND GRIND ALL CUT EDGES SMOOTH.

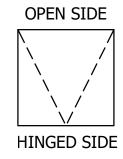

	PRECAST CONCRETE VAULT SCHEDULE			
ID NO.	MODEL	APPROX. INTERIOR DIMENSIONS (L X W X H)		
[V]	H2 PRE-CAST 810 VAULT OR APPROVED EQUAL	10'-0" X 8-0", SEE ELEVATION VIEW FOR DEPTH		
<u>(</u> 2	H2 PRE-CAST 72" DIAMETER MANHOLE - TYPE 3 OR APPROVED EQUAL	72" DIAMETER, SEE ELEVATION VIEW FOR DEPTH		



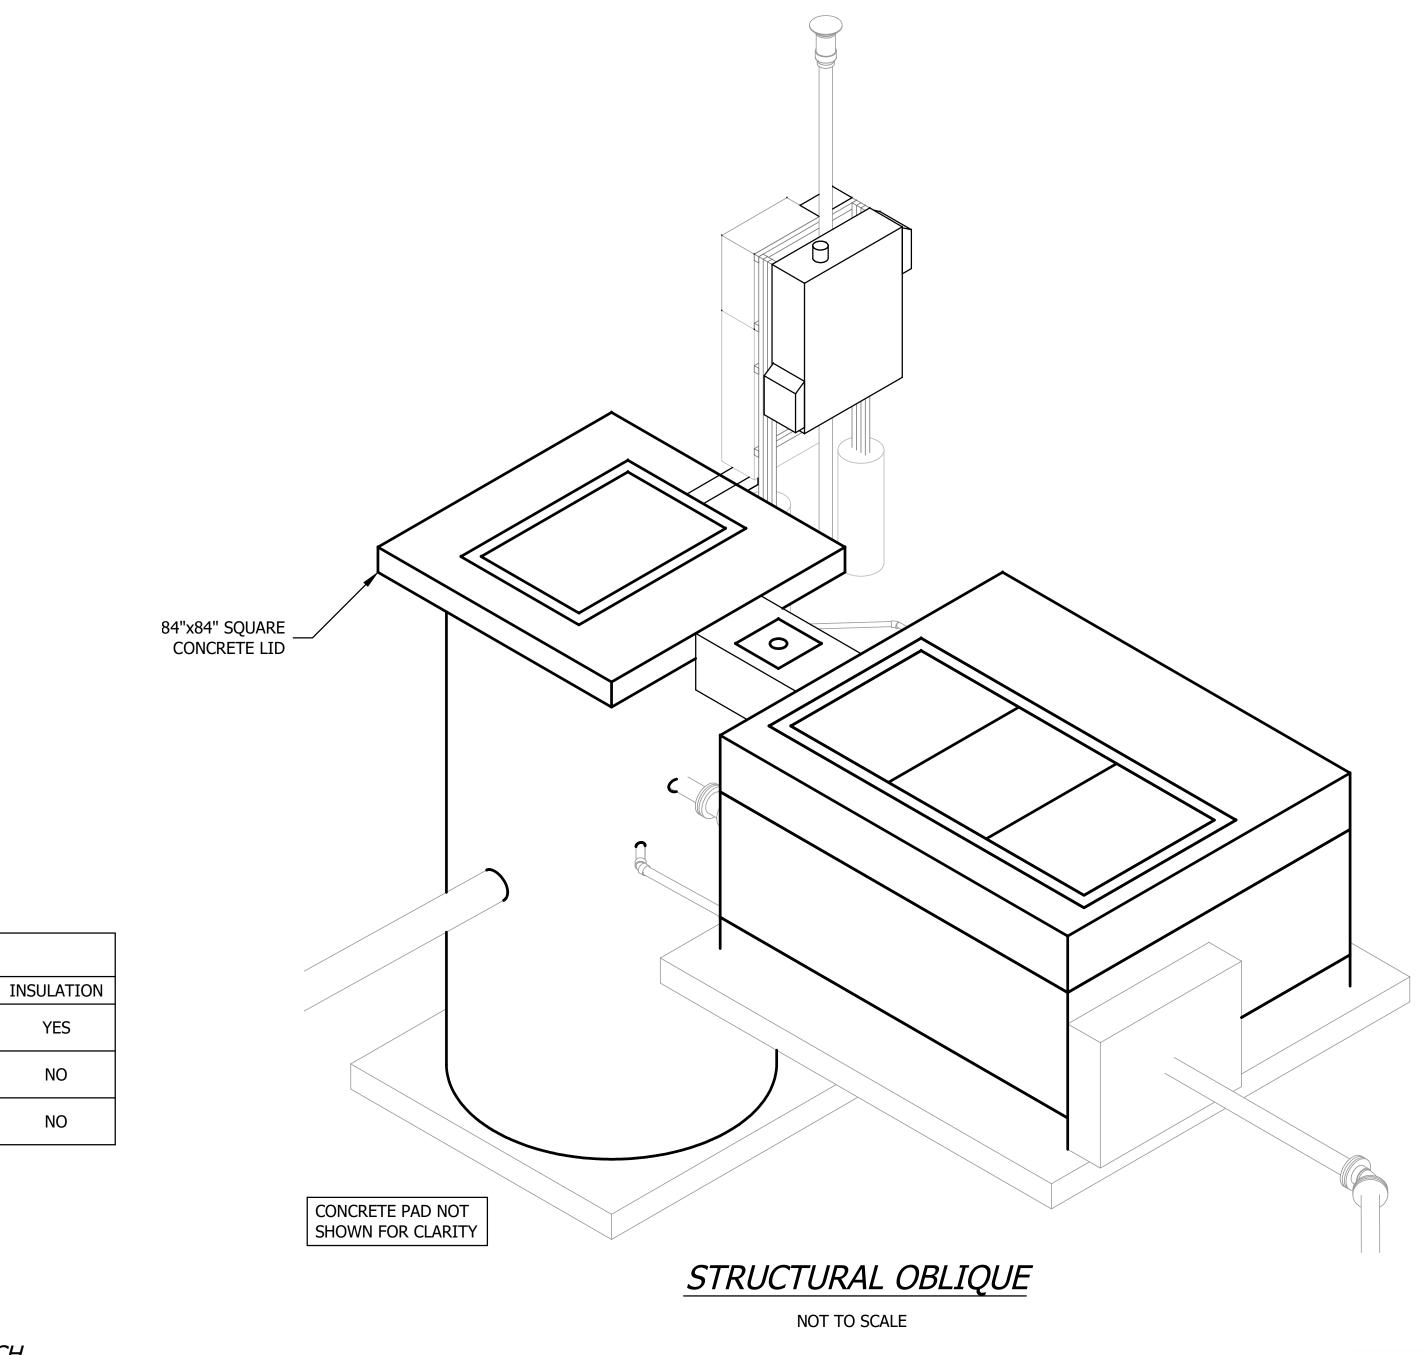





YES

NO

NO

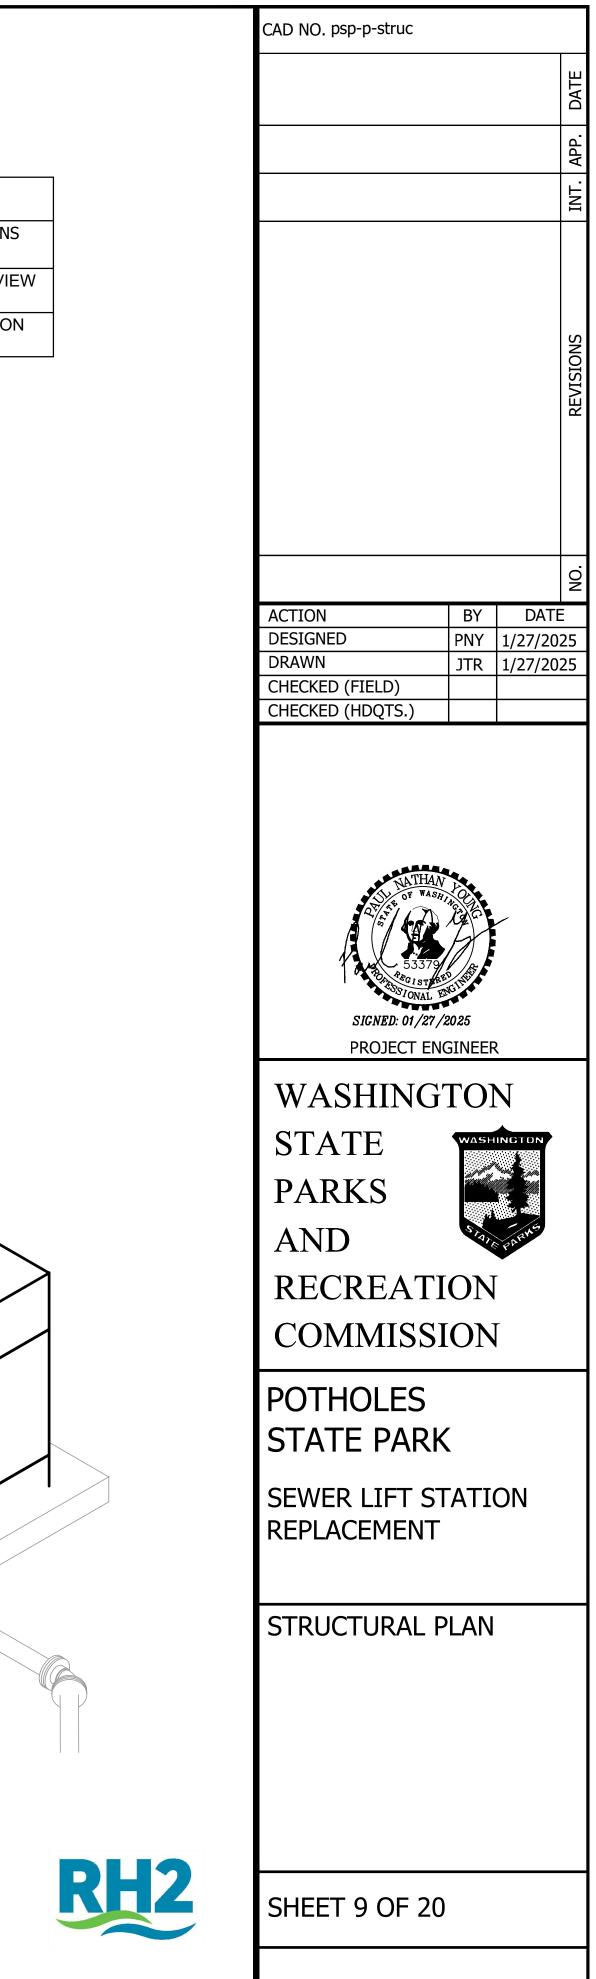

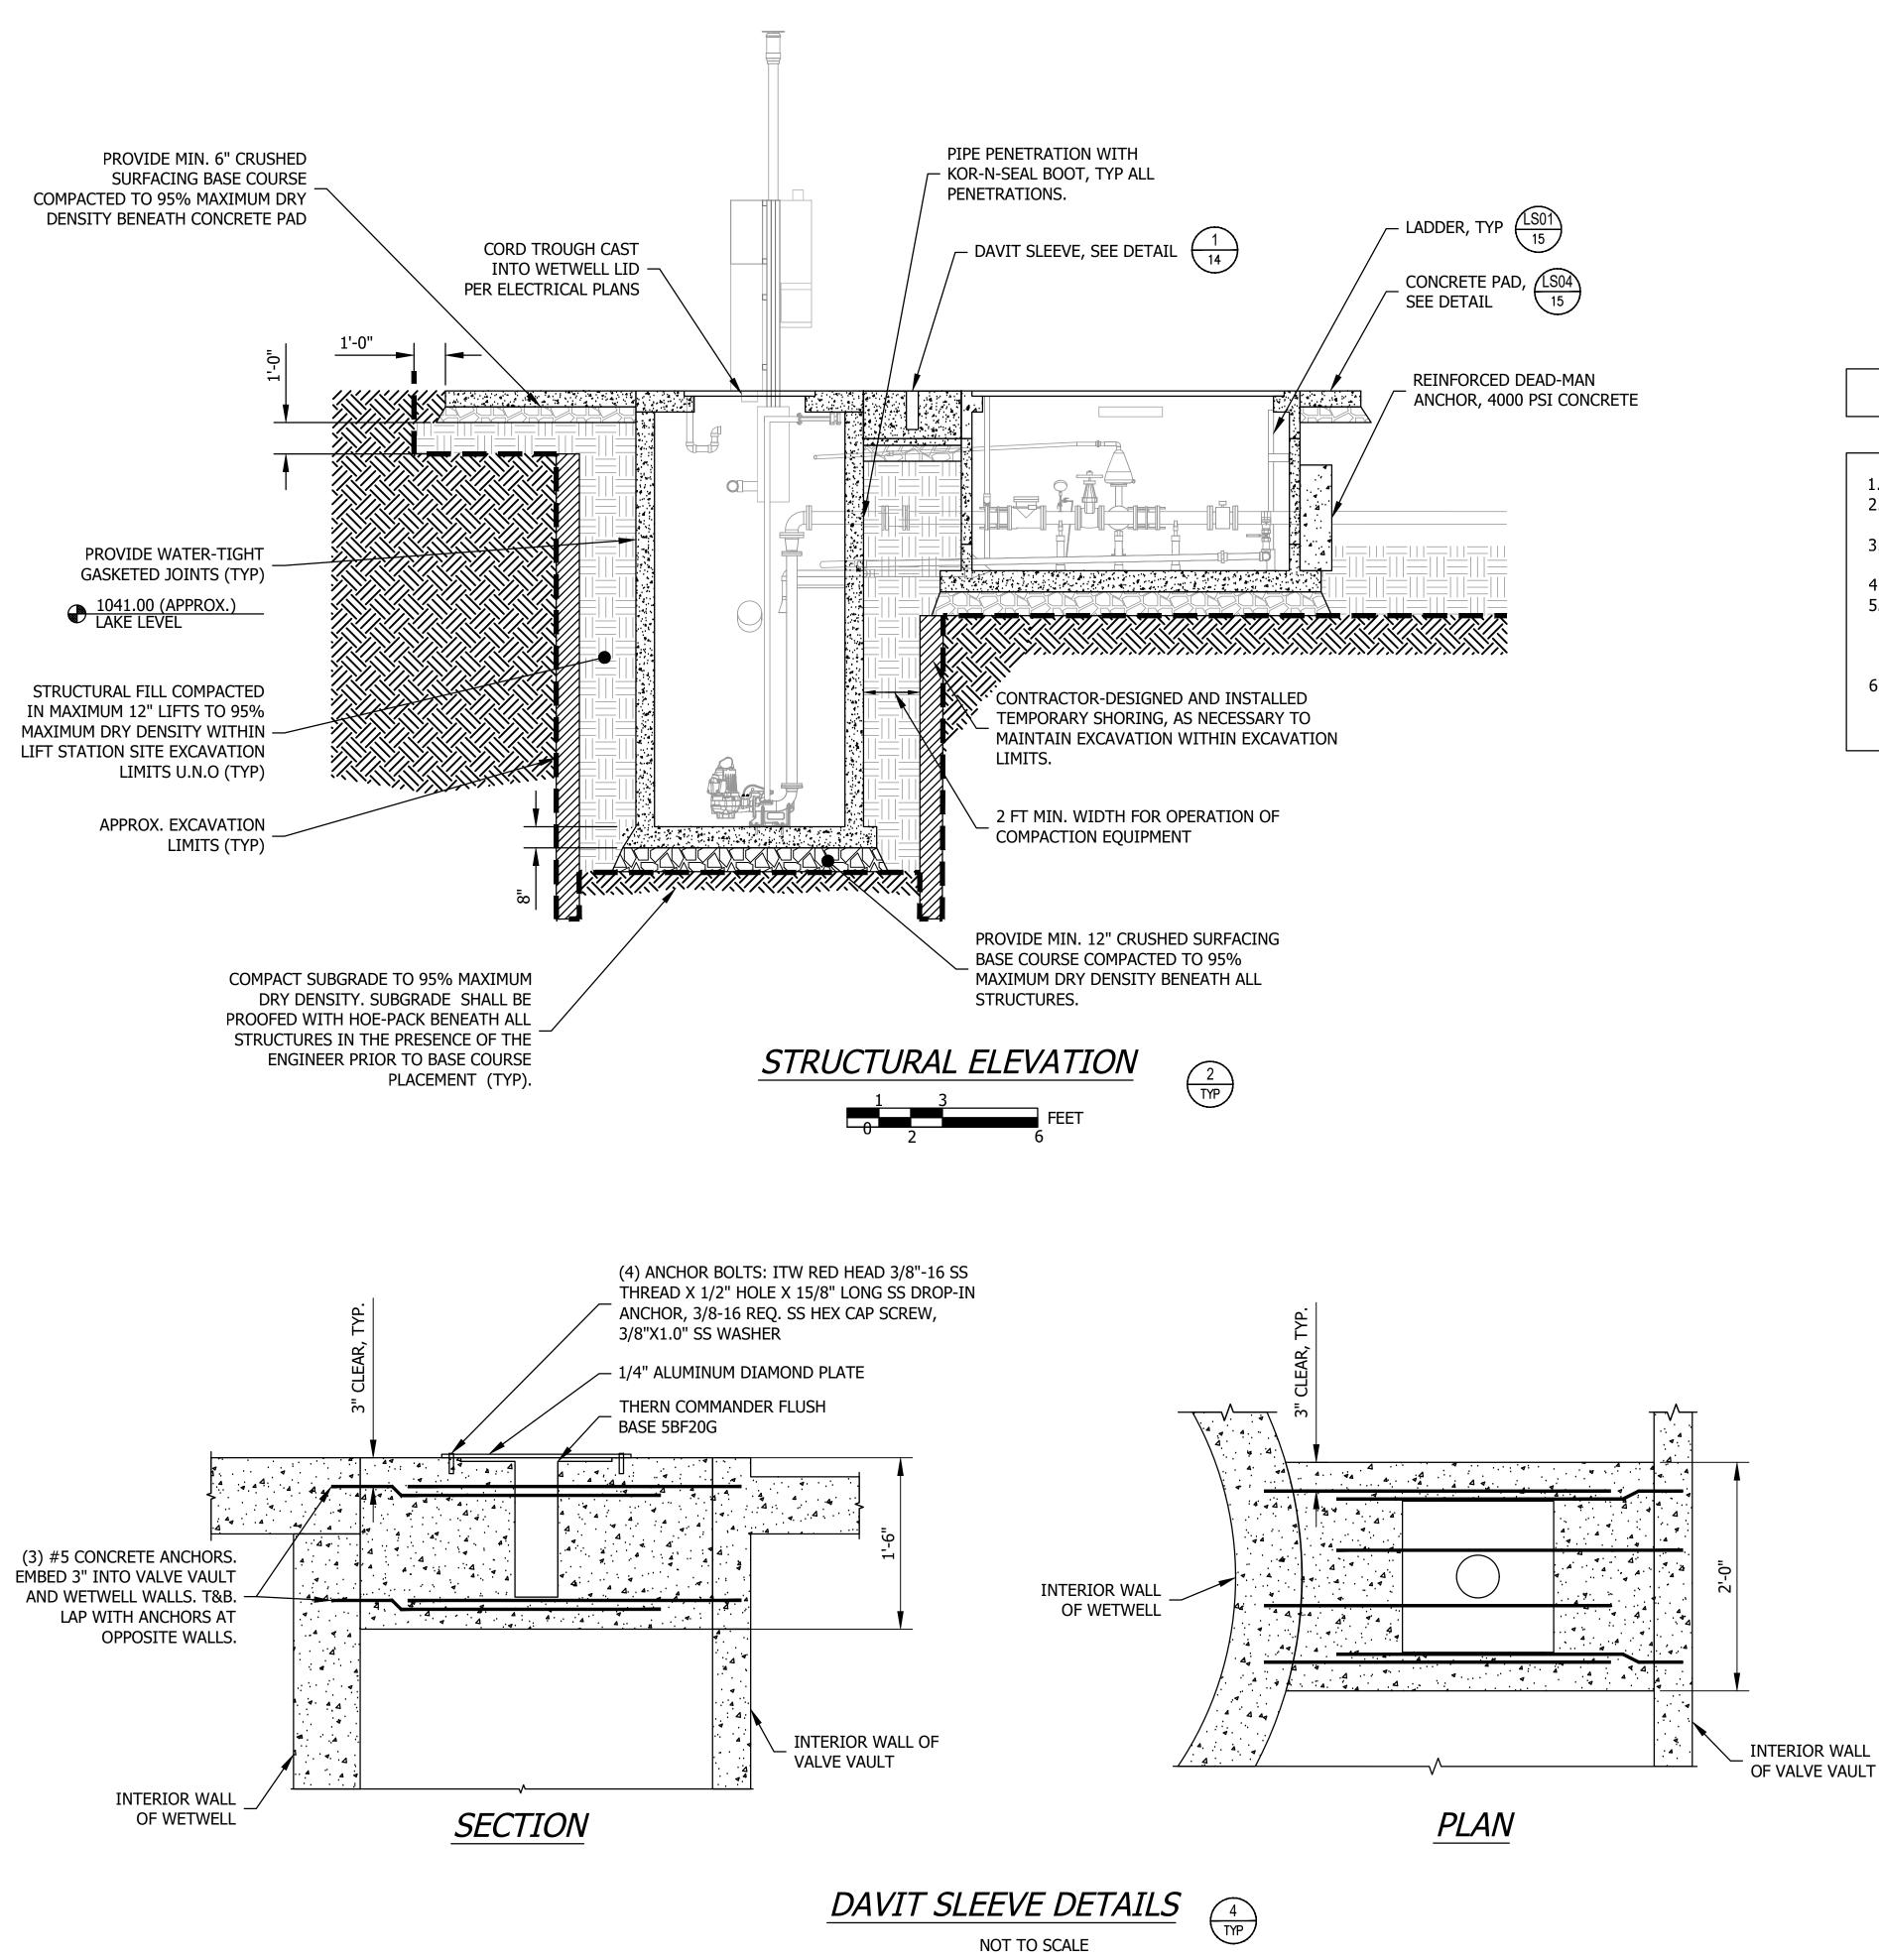



- 1. ALL STRUCTURE RIMS SHALL BE SET 2" ABOVE EXISTING GRADE. 2. MAXIMUM DRY DENSITY OF FILL SHALL BE DETERMINED BY THE MODIFIED
- PROCTOR TEST (ASTM D 1557) 3. EXPOSED EXTERIOR ROOFS OF ALL PRECAST STRUCTURES SHALL BE COATED PER
- THE SPECIFICATIONS.
- 4. THE INTERIOR OF THE WETWELL SHALL BE COATED PER THE SPECIFICATIONS. CONCRETE ANTI-FLOTATION BASES TO BE PRE-CAST AROUND WETWELL BASES. 5. BOTTOM ELEVATION OF ANTI-FLOTATION BASES TO MATCH BOTTOM ELEVATION
- NECESSARY TO MATCH STRUCTURE CLEARANCE HEIGHTS SHOWN ON PLANS. GROUNDWATER IS TO BE EXPECTED IN THE EXCAVATION. CONTROL WATER TO 6. KEEP EXCAVATION DRY DURING INSTALLATION. SEE SPECIFICATIONS DIVISION
- 31.

	MINIMUM STRAIGHT DEVELOPMENT LENGTHS		MINIMUM LAP SPLICE LENGTHS	MINIMUM EMBEDMENT LENGTHS
BAR	TENSIC	ON BARS	TENSION BARS	END HOOKS
SIZE	TOP BARS	OTHER BARS	TOP BARS	ALL BARS
#3	19"	15"	25"	6"
#4	25"	19"	33"	7"
#5	31"	24"	41"	9"
#6	37"	29"	49"	10"
#7	54"	42"	71"	12"
#8	62"	48"	81"	14"
#9	70"	54"	91"	15"
#10	79"	61"	103"	17"

+ "TOP BARS" ARE HORIZONTAL BARS WITH MORE THAN 12" DEPTH OF CONCRETE CAST BELOW THEM. IF CLEAR CONCRETE COVER IS LESS THAN 2x THE DIAMETER OF THE BAR OR THE CENTER-TO-CENTER SPACING IS LESS THAN (4) BAR DIAMETERS, THEN VALUES SHALL BE INCREASED BY 43%.

> REINFORCEMENT SPLICE AND DEVELOPMENT LENGTH SCHEDULE



SHEET 10 OF 20

ELEVATIONS AND PLAN


STRUCTURAL

POTHOLES STATE PARK SEWER LIFT STATION


REPLACEMENT

AND RECREATION COMMISSION

PARKS

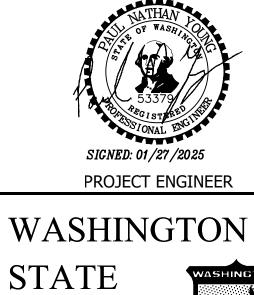

PROJECT ENGINEER

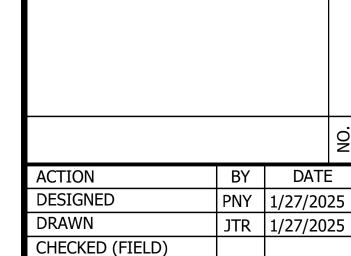


CHECKED (HDQTS.)


CAD NO. psp-p-struc


OF WETWELL BASES. PRECAST STRUCTURES TO BE PROVIDED WITH RISERS AS



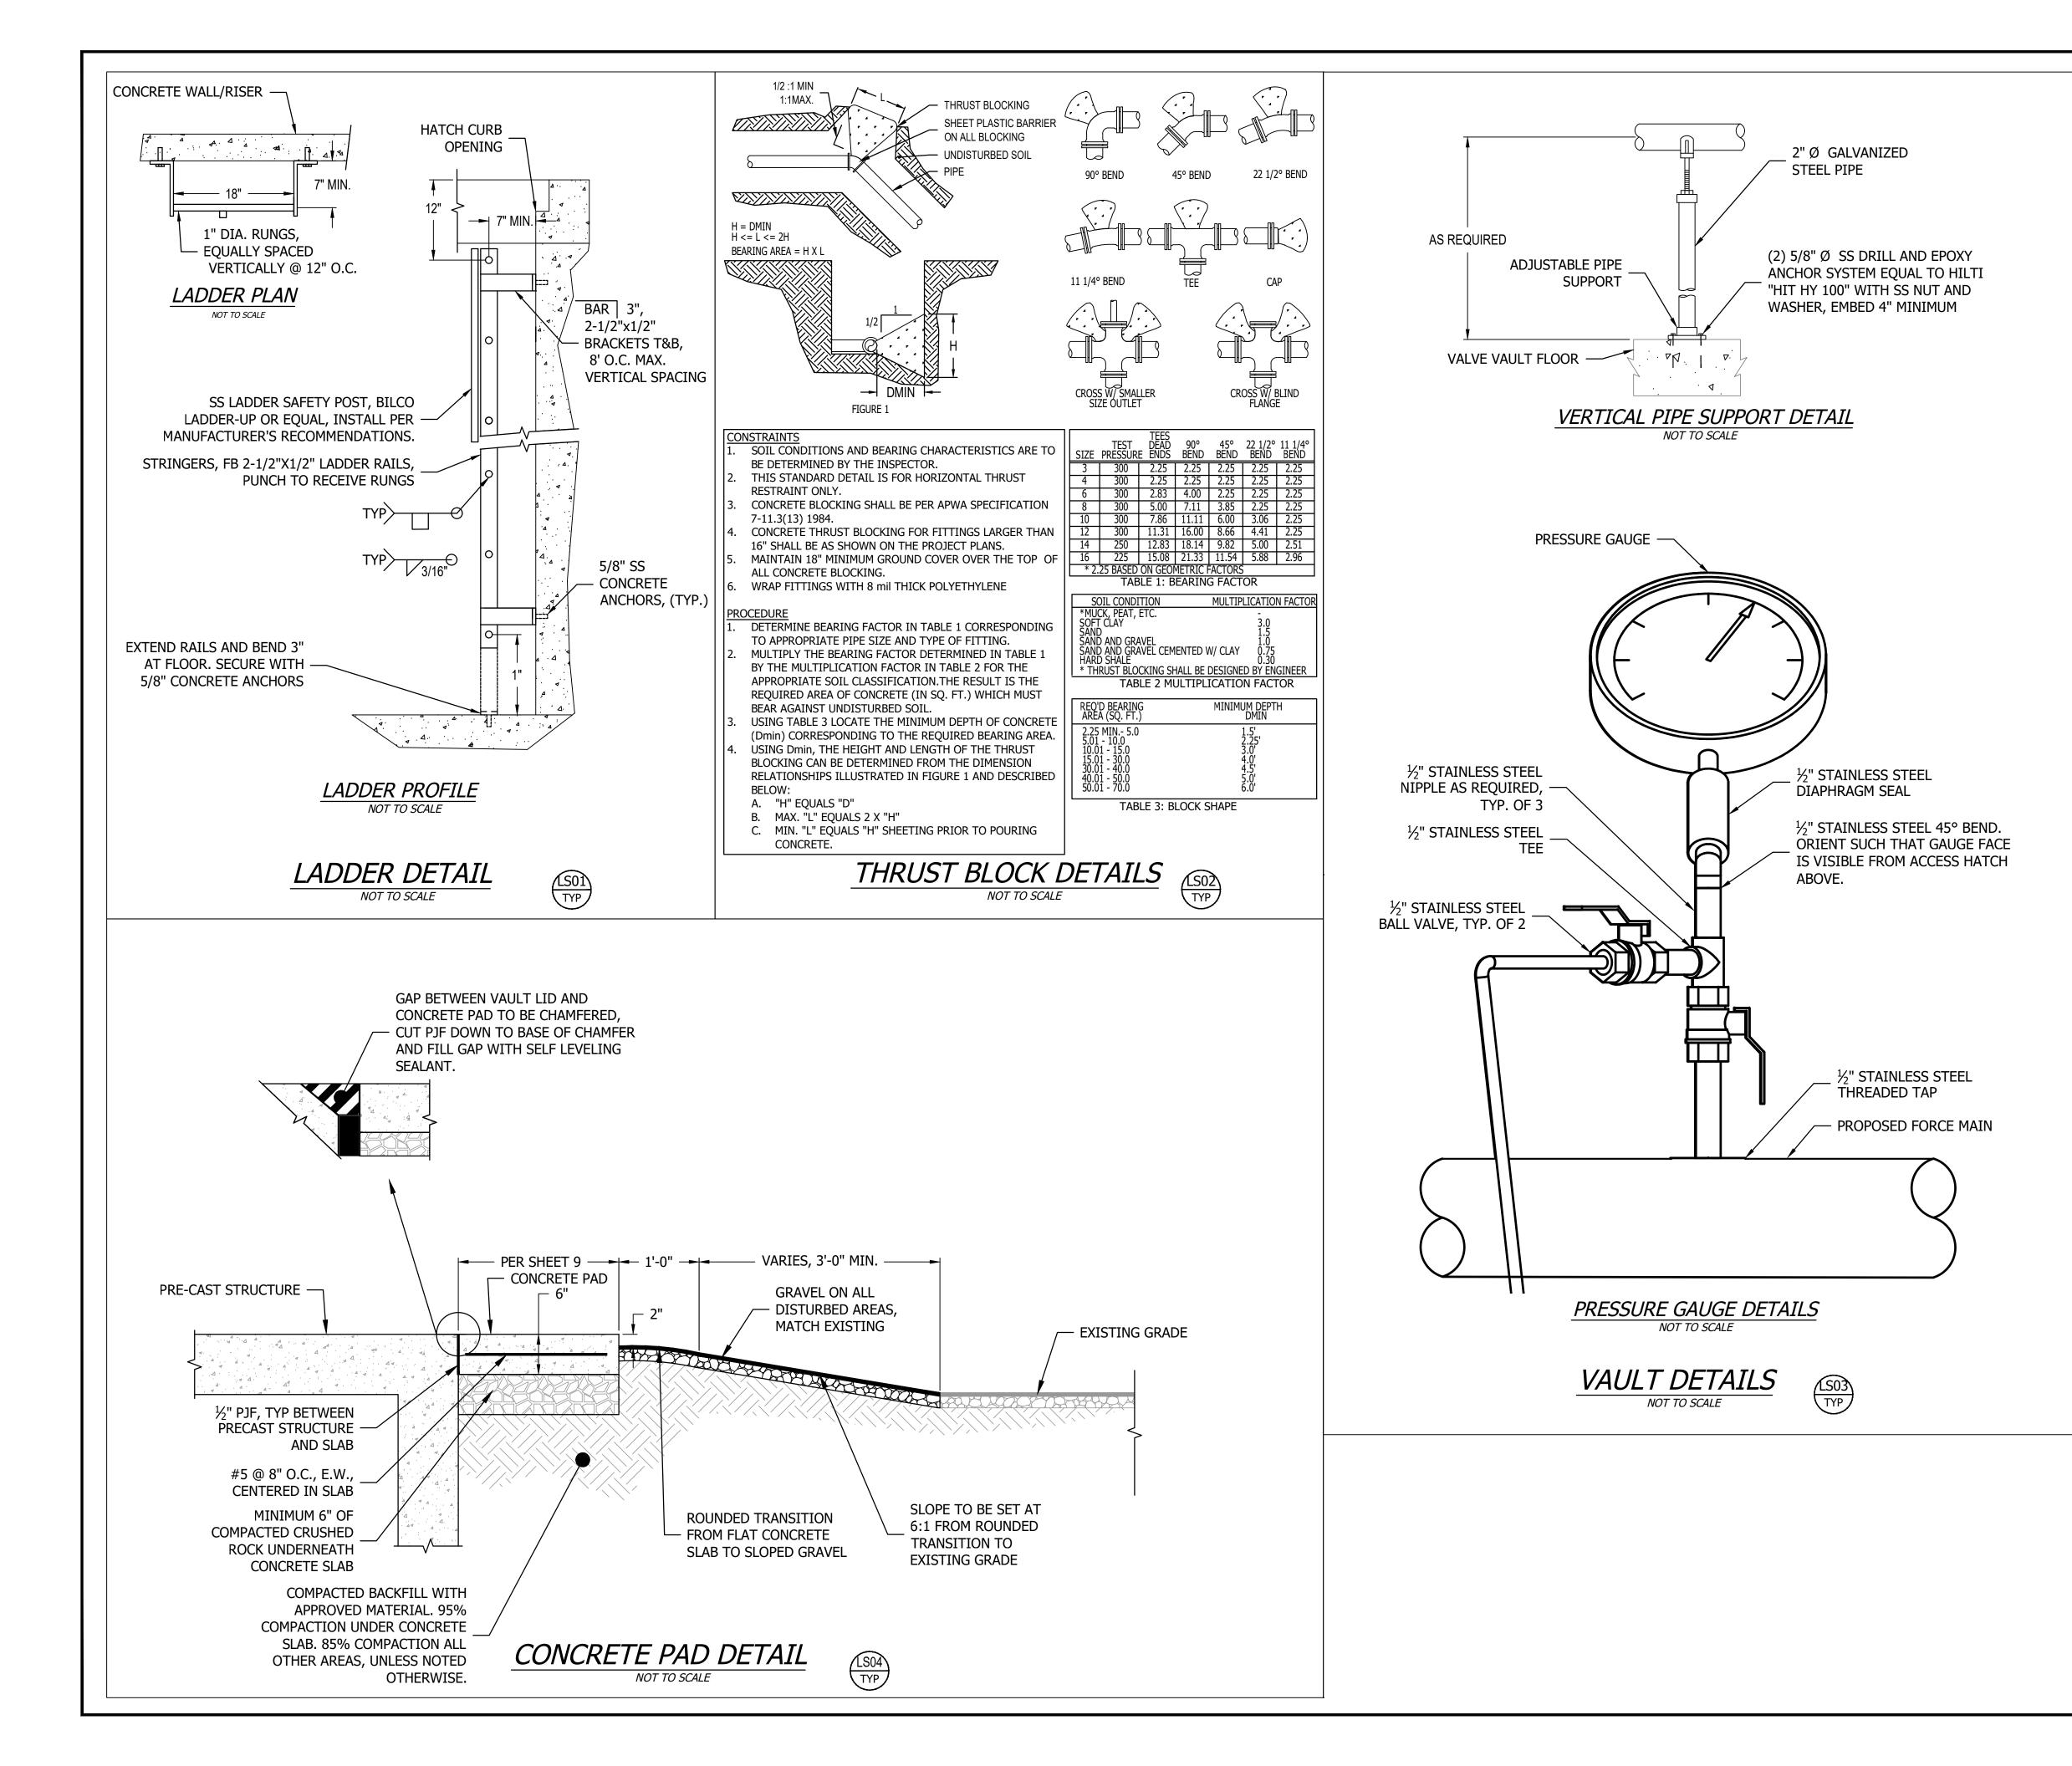


	CAD NO. PSP-P-LSDET
	DATE
	APP.
	INT.
	REVISIONS
	No
	ACTIONBYDATEDESIGNEDPNY1/27/2025
	DRAWNJTR1/27/2025CHECKED (FIELD)CHECKED (HDQTS.)
	AND RECREATION
	COMMISSION POTHOLES
	STATE PARK
	SEWER LIFT STATION REPLACEMENT
	LIFT STATION DETAILS 1
RH2	SHEET 11 OF 20

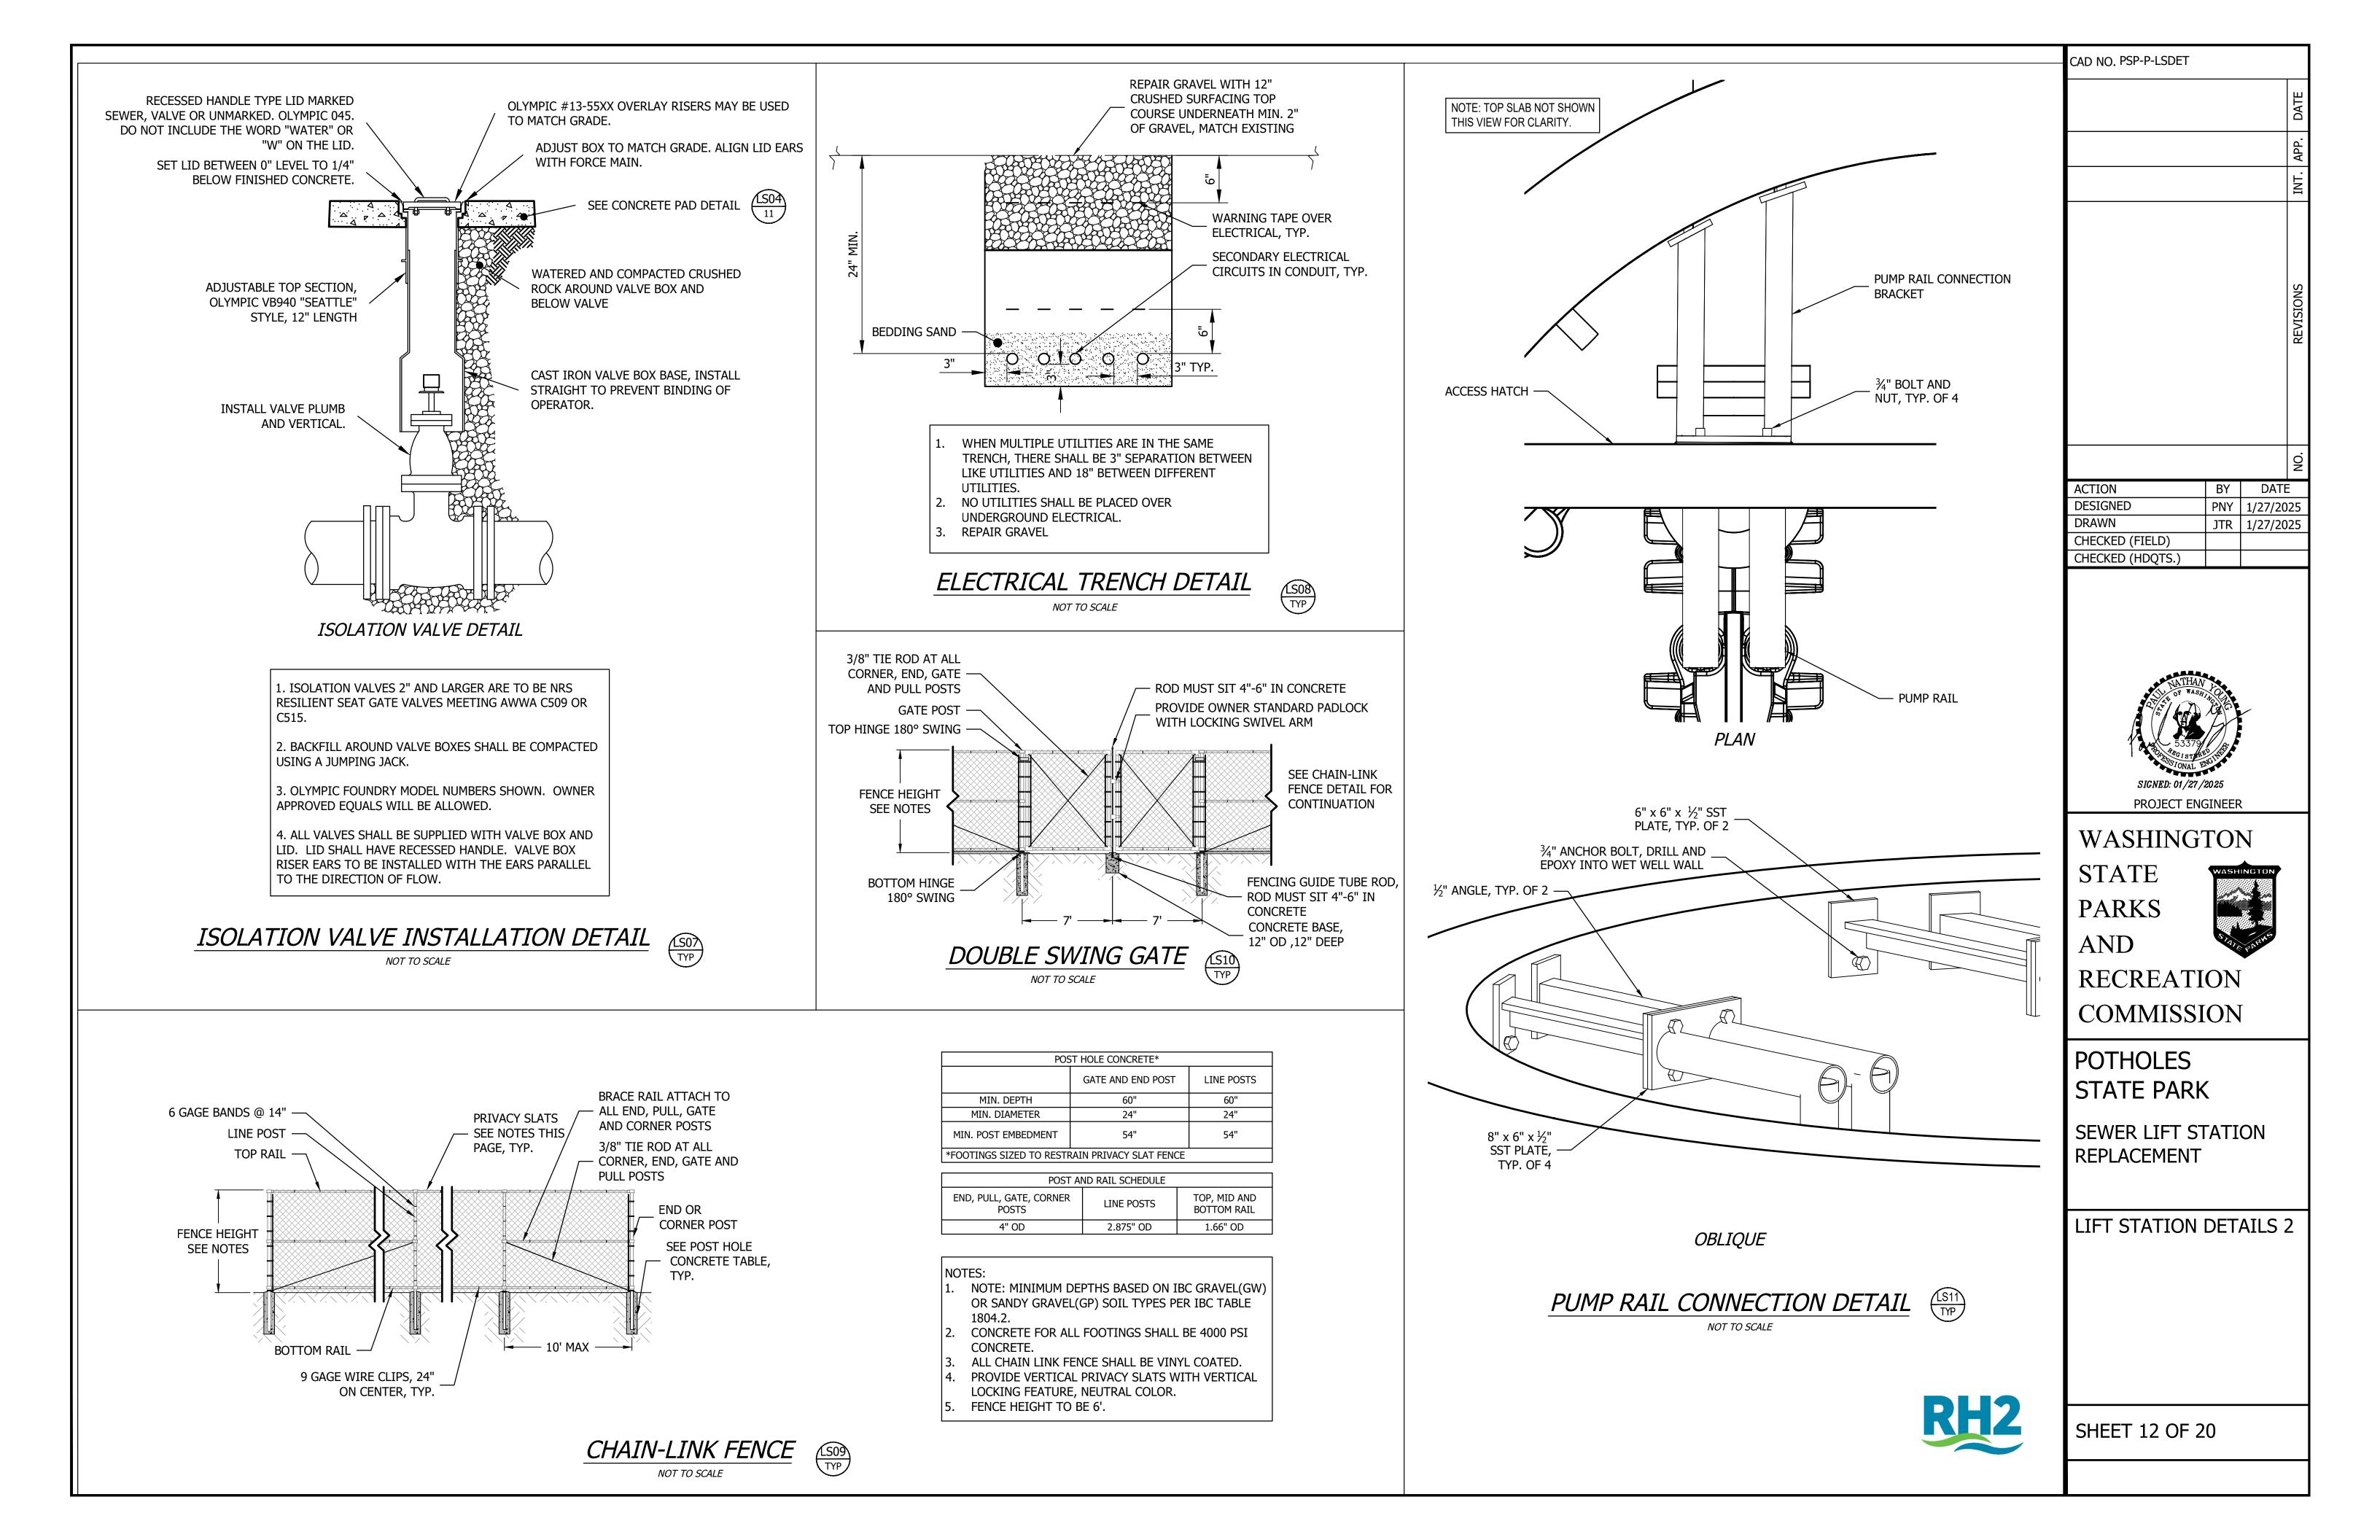

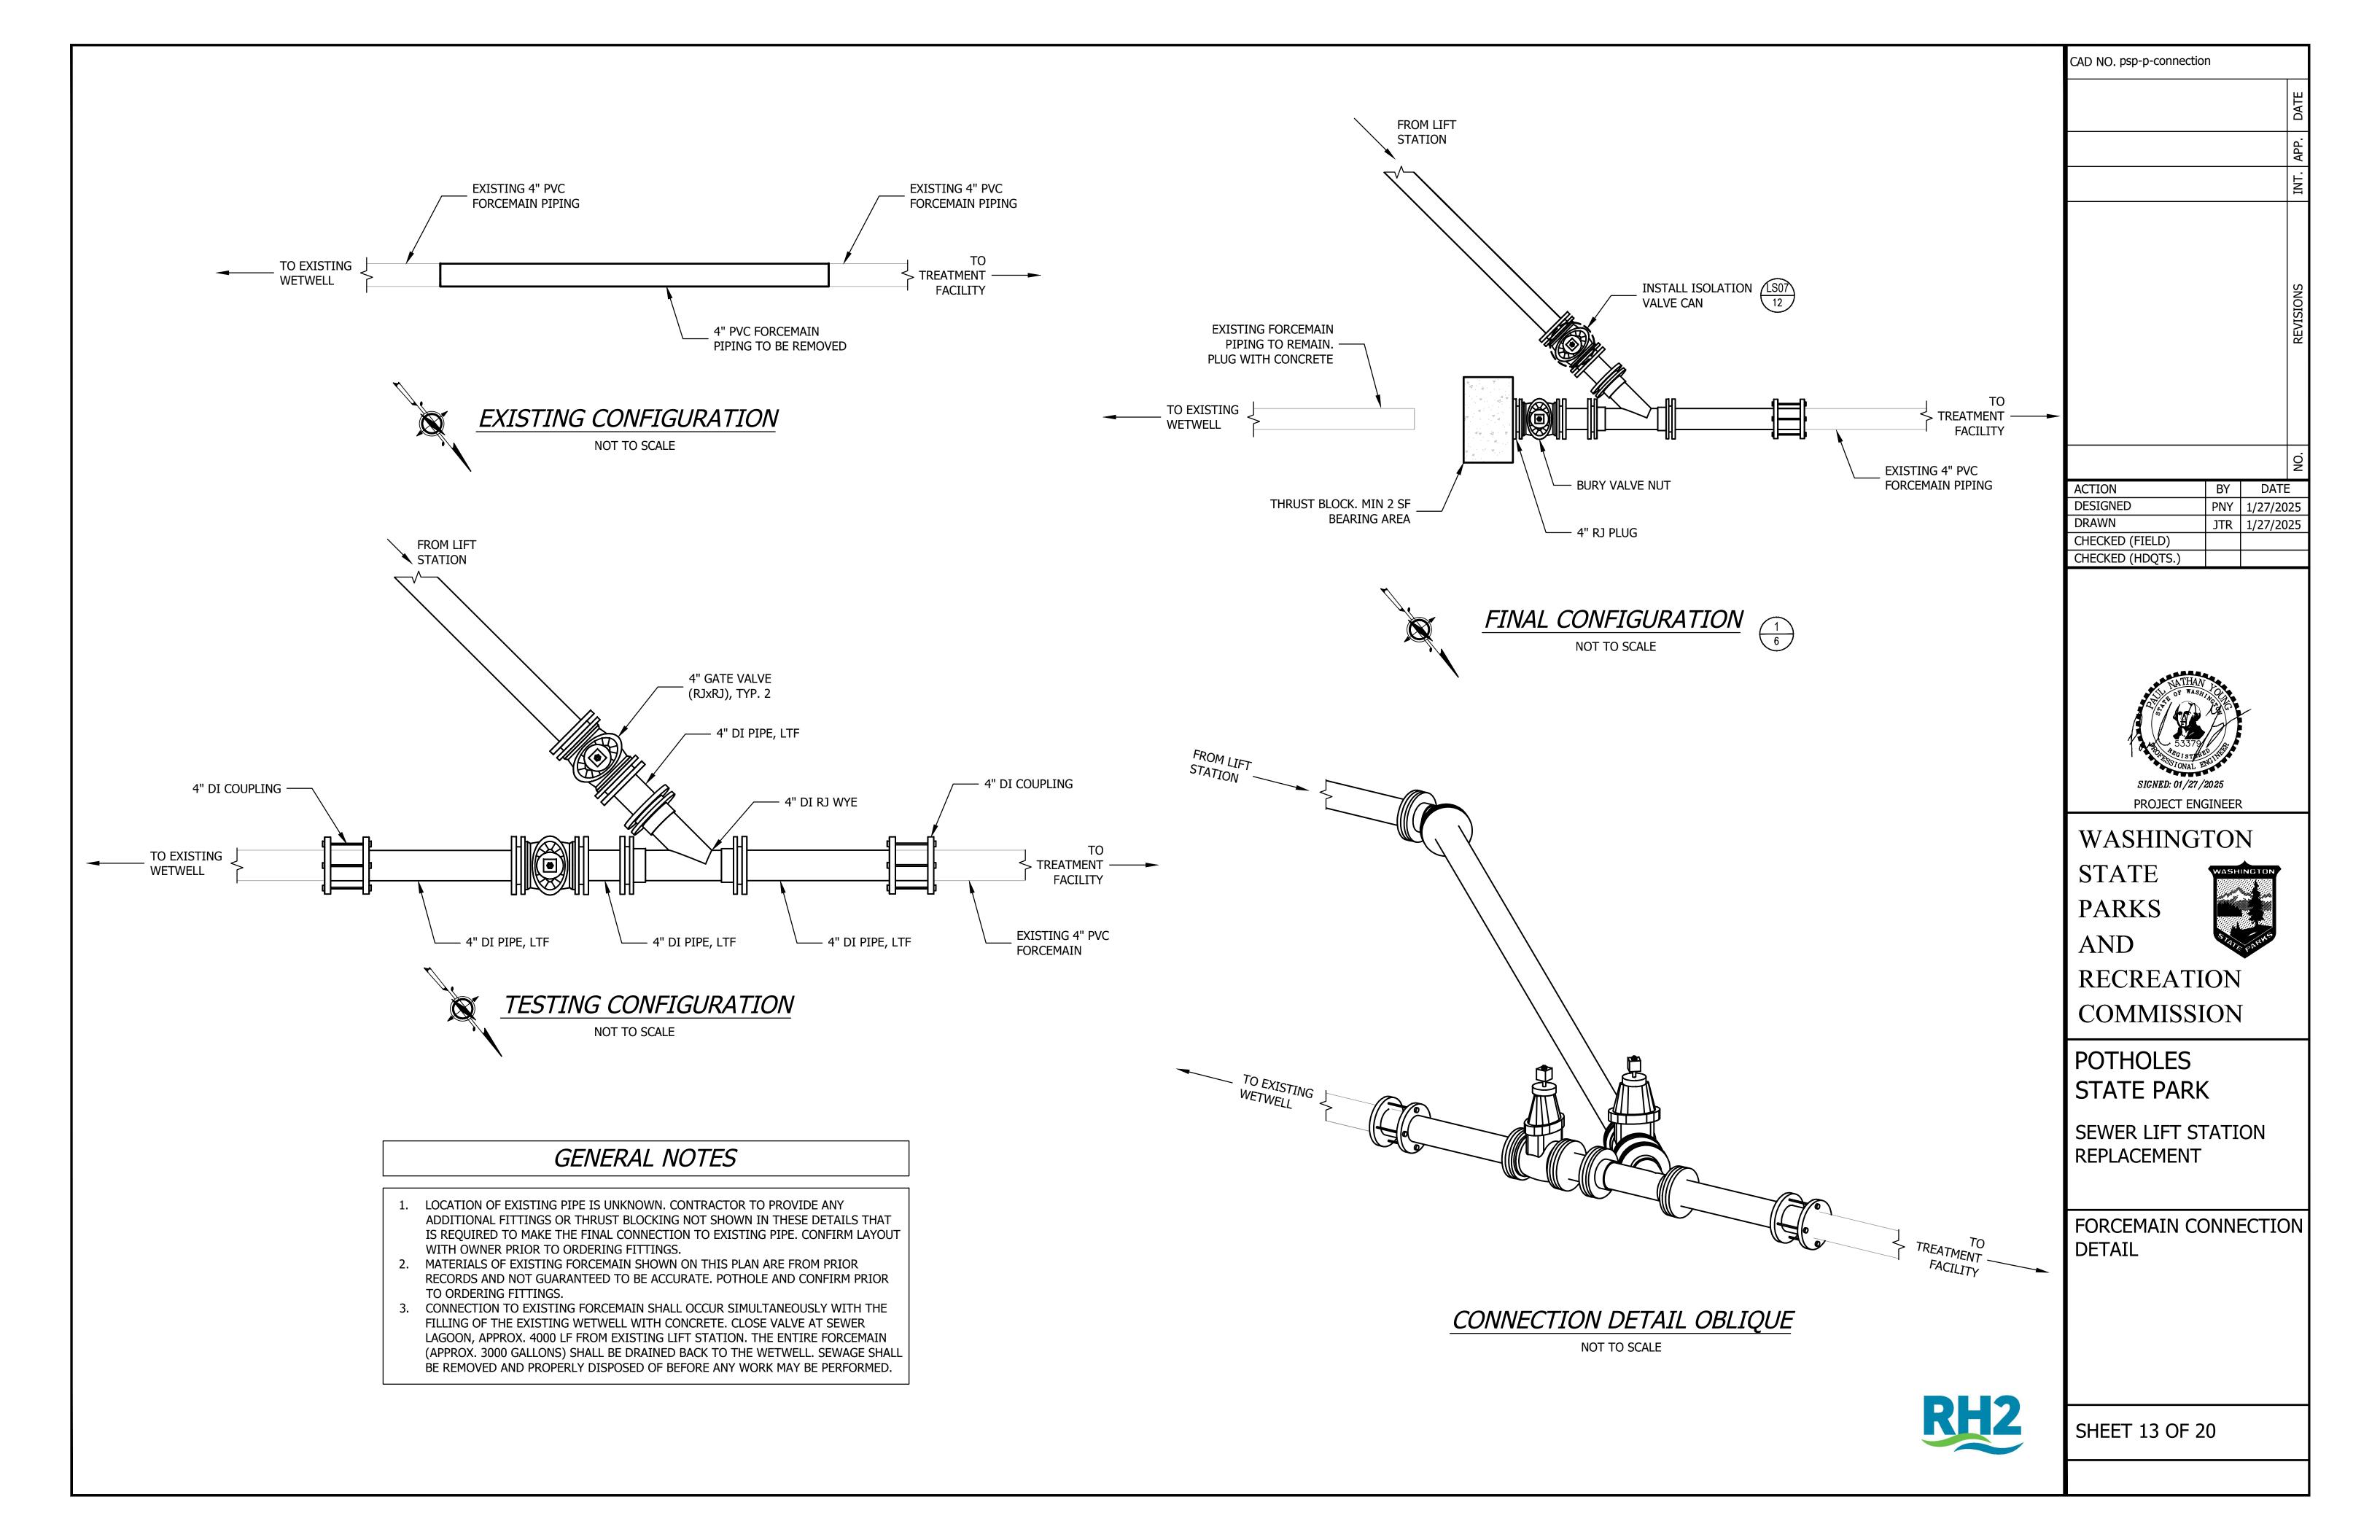

ONE-LINE DIAGRAM SYMBOLS	PANELBOARDS, SWITCHES, AND EQUIPMENT	LIGHTING FIXTURES/DEVICES	ABBREVIATIONS	LADDER LOGIC SYMBOL LEGEND
CIRCUIT BREAKER	SERVICE ENTRANCE, SWITCH		SPDT - SINGLE POLE, DOUBLE THROW SPST - SINGLE POLE, SINGLE THROW	INDICATOR LIGHT RELAY
XXX/YY - CB SIZE & NO. OF POLES ET - ELECTRONIC TRIP	MOTOR CONTROL CENTER, O PANELBOARD		DPST - DOUBLE POLE, SINGLE THROW WP - WEATHER-PROOF	A - AMBER G - GREEN
TM - THERMAL MAGNETIC BREAKER MCP - MOTOR CIRCUIT PROTECTOR		WALL/CEILING MOUNTED FIXTURE	GFI - GROUND FAULT INTERRUPT P - POWER	C - CLEAR W - WHITE
SE - SERVICE ENTRANCE GFI - GROUND FAULT INTERRUPTER	SURFACE MOUNTED PANELBO	ARD	C - CONTROL J - INSTRUMENTATION	LABEL
			PC - POWER & CONTROL CJ - CONTROL & INSTRUMENTATION	LIMITSWITCH LIMIT SWITCH, NORMALLY OPEN FLOAT SWITCH, NORMALLY OPEN
	FLUSHED MOUNTED PANELBO	ARD CONTAINED BATTERY	CKT CIRCUIT C.O CONDUIT ONLY	
RTM RUN TIME METER			N.L NIGHT LIGHT AL ALUMINUM	LIMITSWITCH LABEL
0C     MOTOR OPERATION COUNTER	NXX FIELD CONTROL STATION WIT NEMA REQUIREMENTS.	H SURFACE OR PENDANT MOUNTED FIXTURE	CU COPPER SST - STAINLESS STEEL	General Closed FLOAT SWITCH, NORMALLY CLOSED
SSRVS	N1 - NEMA 1 N3R - NEMA 3R	RECESSED FIXTURE	HOA HAND-OFF-AUTO SWITCH RTM RUN TIME METER	
SSRVS - SOLID STATE REDUCED	N4 - NEMA 4 N4SS - NEMA 4 STAINLESS S	TEEL (MD) MOTION DETECTOR	OC OPERATION COUNTER	LABEL TIME DELAY CONTACT, NORMALLY OPEN, TIME TO CLOSE PUSHBUTTON, NORMALLY CLOSED
VOLTAGE STARTER	N4F - NEMA 4 FIBERGLASS N6 - NEMA 6		SFIL         SEAL FAIL INDICATION LIGHT           SFTR         SEAL FAIL TRIP RESET	
	N12 - NEMA 12 GASKETED	PC PHOTO CONTROL CELL	OTIL OVER TEMPERATURE INDICATION LIGHT MOIL MOTOR OVERLOAD INDICATION LIGHT	LABEL PUSHBUTTON NORMALLY OPEN
VARIABLE FREQUENCY DRIVE	EQUIPMENT MOUNTING STAN	FIRE SYSTEM SYMBOLS		O     TIME DELAY CONTACT, NORMALLY     PUSHBUTTON, NORMALLY OPEN       CLOSED, TIME TO OPEN     O     O
		H HEAT DETECTOR	INDICATE TYPE BY LETTER INSTRUMENT METER	
MOTOR STARTER	HEATER, WATTAGE NOTED	S SMOKE DETECTOR		LABEL THERMOSTAT
MOTOR STARTER W/ OPERATOR DEVICES		D FIRE ALARM DISPATCH STROBE ALARM	A - AMMETER VAR - VARMETER AH - AMPERE-HOUR VARH - VARHOUR METER	TIME TO OPEN
B - OPERATIONAL COUNTER	EQUIPMENT CONNECTION	A FIRE ALARM AUDIBLE/VISUAL ALARM	PF - POWER FACTOR W - WATTMETER V - VOLTMETER WH - WATTHOUR METER	LABEL THERMOSTAT
C - RUN TIME METER D - RUN LIGHT	M SINGLE PHASE MOTOR. HORSEPOWER AS NOTED	F FIRE ALARM MANUAL PULL STATION	AH VA - VOLT AMMETER	TIME DELAY CONTACT, NORMALLY CLOSED, TIME TO CLOSE
E - FAIL LIGHT F - EMERGENCY STOP		ADDITIONAL SYMBOLS	RACEWAY LEGEND	
K KIRK KEY INTERLOCK	THREE PHASE MOTOR. HORSEPOWER AS NOTED	Sound System Speaker	PROPOSED POWER	NAME FLOWSWITCH RELAY CONTACT, INSTANTANEOUS CHANGE
POWER TRANSFORMER			TEL PROPOSED TELEPHONE	NAME
CONTROL POWER TRANSFORMER	HP SINGLE PHASE MOTOR. HORSEPOWER AS NOTED			
			FO PROPOSED FIBER OPTICS	PRESSURE FLOWSWITCH NORMALLY CLOSED
		VALVE SYMBOLS	G PROPOSED GROUNDING	PRESSURE SWITCH, NORMALLY OPEN
CURRENT TRANSFORMER	DISCONNECT SWITCH	- PILOT VALVE SOLENOID		
	FUSED DISCONNECT SWITCH			PRESSURE
$\rightarrow$ $\leftarrow$ VOLTAGE TRANSFORMER			CONDUIT RUN, BROKEN AND CONTINUED SAME SHEET OR AS NOTED	O PRESSURE SWITCH, NORMALLY CLOSED 2 POLE SWITCH
CONTACTOR	COMBINATION MOTOR STAR AND DISCONNECT SWITCH			
			CONDUIT RUN. HATCH MARKS INDICATE NUMBER OF CONDUCTORS	LADDER LOGIC LINETYPES
	RECEPTACLES AND JUNCTION BOX SYMBOLS		CALLOUT INDICATING CONDUIT SIZE, NUMBER AND SIZE OF WIRE.	COMPONENT INSTALLED INSIDE ENCLOSURE
	(J) CEILING JUNCTION BOX		∑ ½" GRC, 2-#12	COMPONENT INSTALLED O 3 POLE SWITCH
GENERATOR CONNECTION RECEPTACLE	(J) WALL JUNCTION BOX		CALLOUT INDICATING CONDUIT PER SCHEDULE	ON FRONT OF ENCLOSURE
IS7	J FLOOR JUNCTION BOX	PID FORMAT		FIELD CONNECTED COMPONENT
SOLID NEUTRAL	DUPLEX WALL RECEPTACLE , 120V WP = WEATHERPROOF	SUPERSCRIPT	CONDUIT BENT UP OR TOWARD	
TB TERMINAL BLOCK	G = GROUNDED IG = ISOLATED GROUND	XYZ ### X=MEASURED OR INITIATING VARIABLE	) CONDUIT BENT DOWN OR AWAY	P&ID BUBBLE IDENTIFICATION CHART
	GFI = GROUND FAULT INTERRUPTER	ABC INSTRUMENT Z=MODIFIER	CAPPED CONDUIT	EXISTING FUNCTION
	DOUBLE DUPLEX	BUBBLE ABC=LOOP NUMBER	ONE-LINE DIAGRAM INFORMATION	INSTRUMENT IDENTIFICATION BUBBLE
SPD SURGE PROTECTION DEVICE (ALTERNATIVE)	SINGLE RECEPTACLE, 120V	ISA STANDARDS FOR P&ID		
, (	SINGLE RECEPTACLE, 208V	1st LETTER (MEASURED     2nd LETTER (READOUT     3rd LETTER       OR INITIATING VARIABLE)     OR FUNCTION)     (MODIFIER)	EXISTING EQUIPMENT AND CONDUIT	FIELD MOUNTED DEVICE OR INSTRUMENT
GROUNDING SYSTEM SYMBOLS	DUPLEX FLOOR RECEPTACLE, 120		PROPOSED EQUIPMENT AND CONDUIT	
	SPECIAL PURPOSE WALL RECEPTACLE, RATING AS NOTED	A     ANALYSIS     ALARM       B     BURNER     (BATTERY)       C     COMMUNICATION     CONTROL		FRONT PANEL MOUNTED INSTRUMENT OR DEVICE (LOCAL PANEL)
METAL PIPE GROUND		D DENSITY (DELAY) E VOLTAGE		
		F FLOW		BACK PANEL MOUNTED INSTRUMENT OR DEVICE (LOCAL PANEL)
WELD. CADWELD OR APPROVED EQUAL.	TV TELEVISION	G GAS I GREEN BULB		FRONT PANEL MOUNTED INSTRUMENT OR DEVICE (LAB ROOM PANEL)
GROUND ROD SIZED PER N.E.C. USE EXOTHERMIC WELD CONNECTION AT THE GROUND ROD.	TELEPHONE	URRENT (INTRUSION) INDICATE J POWER (EQUIPMENT)		
	TELEPHONE/DATA WITH CABLE	K TIME CONTROL STATION		OPERATOR INTERFACE DISPLAY (LOCAL PANEL)
REQUIRED, 8' MINIMUM.	TELEPHONE/DATA WITHOUT CABL	L     LEVEL     LIGHT     LOW       M     MOTION     MIDDLE		OPERATOR INTERFACE DISPLAY (LAB ROOM PANEL)
CONNECTION POINT, MECHANICAL, COMPRESSION TYPE.	SWITCH OUTLETS	N     USERS CHOICE     OPEN       O     USERS CHOICE     OPEN		
ELECTRICAL SITE PLAN SYMBOLS	S STANDARD SWITCH, 120VAC, 20	P PRESSURE (PUMP) (PRESSURE)		
UTILITY POLE AND GUY WIRE	AMP	Q     QUANTITY     (EVENT)     TOTALIZE       R     RADIATION     (REQ'D)     RECORD       R     CMUTCH     COLENDID		GENERAL NOTES
	S S 3WAY 3-WAY SWITCH, 120VAC, 20 AMP	SSPEED (SMOKE)SWITCHSOLENOIDTTEMPERATURETRANSMITTER(TRANSMITTER)		1. THIS IS A STANDARD LEGEND. NOT ALL OF THE INFORMATION SHOWN ON THIS PAGE WILL APPEAR IN THIS SET OF PLANS.
				2. THESE DRAWINGS ARE DIAGRAMMATIC ONLY; EXACT LOCATIONS OF ELECTRICAL EQUIPMENT
P BURIED POWER VAULT OR MANHOLE	S S HOA HOA SHITCH, 120VAC, 20 AMP, LABEL SWITCH POSITION HAND-OFF-MOTION OR PHOTO	W WEIGHT		SHALL BE DETERMINED IN THE FIELD BY THE CONTRACTOR. THE INSTALLATION OF ALL EQUIPMENT SHOWN ON THESE DRAWINGS OR DESCRIBED IN THE SPECIFICATIONS SHALL
T TELEPHONE VAULT OR PEDESTAL	SSINGLE-POLE SILOT-LIGHTED	X UNCLASSIFIED Y USERS CHOICE 		CONFORM TO THE REQUIREMENTS SET FORTH IN THE LATEST EDITIONS OF ALL APPLICABLE CODES AND UTILITY COMPANY STANDARDS. CONTACT THE UTILITY COMPANY REPRESENTATIVES
F FIBER OPTICS VAULT OR PEDESTAL	Single-Pole     S       DEE     P       S     DOUBLE-POLE       S     KEY-OPERATED			AND VERIFY THEIR REQUIREMENTS.
	2 K S THREE WAY S LOW VOLTAGE			3. NOTIFY THE ENGINEER IMMEDIATELY IF CONFLICTS IN EQUIPMENT LOCATIONS ARE DISCOVERED OR IF PROBLEMS ARISE DUE TO FIELD CONDITIONS, LACK OF INFORMATION OR
	3 LV S FOUR WAY S MASTER			ANY OTHER REASON. NO PAYMENT WILL BE MADE FOR CHANGES WHICH HAVE NOT BEEN REVIEWED BY THE ENGINEER.
Bad-mount transformer	4 S DIMMER • PUSHBUTTON			
	D			


		LADDER LOGIC SYME	BOL LEGEND			CAD NO. psp-d-e01
	Bits         The Second Autor           Market Office         Description		RELAY			
			123	CR - CONTROL RELAY		
			LABEL			
		MALLY OPEN				
			$\circ$	FLOAT SWITCH, NORMALLY OPEN		
			LABEL			
		MALLI CLOSED	0 0	FLOAT SWITCH, NORMALLY CLOSED		
			0			
		SE				
			PUSHBUTTON			
				PUSHBUTTON, NORMALLY OPEN		
			0 0			
		CI, NORMALLY OPEN,		THERMO SWITCH, NORMALLT OPEN		
			THERMOSTAT			
				THERMO SWITCH, NORMALLY CLOSED		
			<u> </u>			
		STANTANEOUS CHANGE				CHECKED (FIELD)
NORPHALLY OPEN	NORMALLY OPEN			FLOWSWITCH, NORMALLY OPEN		CHECKED (HDQ1S.)
NORPHALLY OPEN	NORMALLY OPEN					
NORMALLY CLOSED  VERT CLOSED  V	NORMALLY CLOSED NORMALLY CLOSED TALLED TALLED TALED TALLED TALLED TALE		FLOWSWITCH			
TALLED       Image: Contract Contract Contract Contract         Strukth Or, 707, 7085       PROJECT ENGINEER	Instrument or device (Local PAREL)         Isstrument or	NORMALLY OPEN	0 0	FLOWSWITCH, NORMALLY CLOSED		
TALLED       Image: Contract Contract Contract Contract         Strukth Or, 707, 7085       PROJECT ENGINEER	Instrument or device (Local PAREL)         Isstrument or					
TALLED       Image: Contract Contract Contract Contract         Strukth Or, 707, 7085       PROJECT ENGINEER	Instrument or device (Local PAREL)         Isstrument or					STION C. ANDRESS
TALLED TALLED CALOSURE       Image: Comparison of the system	TALLED TALLED NORMALLY CLOSED		2 POLE SWITCH		Contraction of the second seco
IRE TALLED AND AND AND AND AND AND AND AND AND AN	INCLUSION OF THE INFORMATION SHALL APPLICABLE COMPANY REPORTED THATLED INFORMATION SHALL APPLICABLE SHITCH		0 0			141 54355
IRE TALLED AND AND AND AND AND AND AND AND AND AN	INCLUSION OF THE INFORMATION SHALL APPLICABLE COMPANY REPORTED THATLED INFORMATION SHALL APPLICABLE SHITCH	5				PARGISTERED NUL
TAILED       PROJECT ENGINEER         PROJECT ENGINEER       WASHINGTON         STATE       PARKS         WASHINGTON CHART       PARKS         ATION BUBBLE       RECREATION         OR INSTRUMENT       RECREATION         OR INSTRUMENT OR DEVICE (LOCAL PANEL)       POTHOLES         INSTRUMENT OR DEVICE (LOCAL PANEL)       POTHOLES         INSTRUMENT OR DEVICE (LOCAL PANEL)       POTHOLES         INSTRUMENT OR DEVICE (LOCAL PANEL)       SEWER LIFT STATION         SERVER LIFT STATION STATUS       SEWER LIFT STATION         REPLACEMENT       ELECTRICAL LEGEND	TALLED       PROJECT ENGINEER         WASHINGTON       STATE         STATE       PARKS         WASHINGTON       STATE         NTION BUBBLE       RECREATION         OR INSTRUMENT       COMMISSION         INSTRUMENT OR DEVICE (LOCAL PANEL)       POTHOLES         STATE PARK       SEWER LIFT STATION         INSTRUMENT OR DEVICE (LOCAL PANEL)       SEWER LIFT STATION         INSTRUMENT THE UNIT ON ON THIS PAGE WILL       SEWER LIFT STATION SHALL         WANDS DE ONTACTORS THE INSTALLAPPLICABLE       SEWER LIFT STATION SHALL APPLICABLE         SET FORTH IN THE LATEST EDITIONS SHALL APPLICABLE					SIGNED: 01/27/2025
ACLOSURE BD WASHINGTON STATE PARKS WASHINGTON STATE PARKS WASHINGTON STATE PARKS RECREATION COMMISSION POTHOLES STATE PARK SEVER LIFT STATION REPLACEMENT ESPLAY (LOCAL PANEL) E	ACLOSURE BD WASHINGTON STATE PARKS WASHINGTON STATE PARKS RECREATION COMMISSION POTHOLES STATE PARK SEVER LIFT STATION REPLACEMENT INSTRUMENT OR DEVICE (LOCAL PANEL) ISPLAY (LAB ROOM PANEL)			3 POLE SWITCH		PROJECT ENGINEER
STATE PARKS STATE PARKS RECREATION COMMISSION RECREATION COMMISSION POTHOLES STATE PARK SEWER LIFT STATION REPLACEMENT INSTRUMENT OR DEVICE (LOCAL PANEL) INSTRUMENT OR DEVICE (LOCAL PANEL) INSTRUMENT OR DEVICE (LOCAL PANEL) ISFLAY (LAB ROOM PANEL) ISFLAY (LAB ROOM PANEL) ISFLAY (LOCAL PANEL) ISFLAY (LO	STATE PARKS STATE PARKS RECREATION COMMISSION POTHOLES STATE PARK SEVER LIFT STATION REPLACEMENT INSTRUMENT OR DEVICE (LOCAL PANEL) INSTRUMENT OR DEVICE (LAB ROOM PANEL) ISPLAY (LOCAL PANEL) ISPLAY (LAB ROOM PANEL) ISPLAY (LOCAL PANEL) ISPLAY (LOC					WASHINGTON
PARKS PARKS PARKS PARKS PARKS RECREATION COMMISSION POTHOLES STATE PARK SEWER LIFT STATION REPLACEMENT INSTRUMENT OR DEVICE (LOCAL PANEL) ISPLAY (LOCAL PANEL) ISPL	RAID BUBBLE IDENTIFICATION CHART         ATION BUBBLE         ATION BUBBLE         OR INSTRUMENT         INSTRUMENT         INSTRUMENT OR DEVICE (LOCAL PANEL)         NSTRUMENT OR DEVICE (LOCAL PANEL)         INSTRUMENT OR DEVICE (LOCAL PANEL)         ISPLAY (LOCATIONS OF ELECTRICAL EQUIPMENT LID BY THE CONTRACTOR. THE INSTALLION OF ALL APPLICABLE BY AND	Ð				•
ATION BUBBLE OR INSTRUMENT OR INSTRUMENT INSTRUMENT INSTRUMENT OR DEVICE (LOCAL PANEL) ISFLAY (LOCATIONS OF ELECTRICAL EQUIPMENT ISFLAY ISF REFERENTIONS OF ALL APPLICABLE WANTION ON THIS PAGE WILL INTERVINEY ON THE UNTRACTOR. THE INSTALLATION OF ALL WANTIC ONLY; EXACT LOCATIONS OF ALL APPLICABLE WANDARDS. CONTACT THE UTILITY COMPANY REPRESENTATIVES ISFL	ATTON BUBBLE  ATTON BUBBLE  OR INSTRUMENT  INSTRUMENT  INSTRUMENT OR DEVICE (LOCAL PANEL)  ISFLAY (LOCAL PANEL)  ISFLAY (LOCAL PANEL)  ISFLAY (LAB ROOM PANEL)  ISF					STATE WASHINGTON
ATION BUBBLE OR INSTRUMENT OR INSTRUMENT OR DEVICE (LOCAL PANEL) ISFLAY (LOCATIONS OF ELECTRICAL EQUIPMENT ISFLAY ISS OR DESCRIBED IN THE SPECIFICATIONS SHALL MATIC ONLY; EXACT LOCATIONS OF ALL APPLICABLE WARARDS. CONTACT THE UTILITY COMPANY REPRESENTATIVES ISFL	ATTON BUBBLE ATTON	&ID BUBBLE IDENTIFIC	CATION CHART			PARKS
OR INSTRUMENT         INSTRUMENT OR DEVICE (LOCAL PANEL)         ISPLAY (LOCAL PANEL)         ISPLAY (LOCAL PANEL)         ISPLAY (LOCAL PANEL)         ISPLAY (LAB ROOM PANEL)         ISPLAY (LAB ROOM PANEL)         ISPLAY (LAB ROOM PANEL)         IDP THE CONTRACTOR, THE INSTALLATION OF ALL         MATIC ONLY; EXACT LOCATIONS OF ELECTRICAL EQUIPMENT         IDP OTH IN THE CONTRACTOR, THE INSTALLATION OF ALL         MANINGS OR DESCRIBED IN THE SPECIFICATIONS SHALL         INDUMARY CONFIT IN THE STEDITIONS OF ALL APPLICABLE         NUMADARDS, CONTRACT THE UTILITY COMPANY REPRESENTATIVES	OR INSTRUMENT         OR INSTRUMENT         INSTRUMENT OR DEVICE (LOCAL PANEL)         NSTRUMENT OR DEVICE (LOCAL PANEL)         INSTRUMENT OR DEVICE (LOCAL PANEL)         INSTRUMENT OR DEVICE (LOCAL PANEL)         INSTRUMENT OR DEVICE (LOCAL PANEL)         ISPLAY (LOCAL PANEL)         ISPLAY (LOCAL PANEL)         ISPLAY (LAB ROOM PANEL)					
OR INSTRUMENT INSTRUMENT OR DEVICE (LOCAL PANEL) INSTRUMENT OR DEVICE (LAB ROOM PANEL) ISPLAY (LOCAL PANEL) ISPLAY (LOCAL PANEL) ISPLAY (LAB ROOM PANEL) ISPLAY (LAT THE INFORMATION SHOWN ON THIS PAGE WILL INMATICS OR DESCRIBED IN THE SPECIFICATIONS SHALL INTEL INFORMATION SOF ELECTRICAL EQUIPMENT ISPLAY (LOCATIONS OF ELECTRICAL EQUIPMENT ISPLAY (LOCATIONS OF ELECTRICAL EQUIPMENT ISPLAY (LOCATIONS OF ALL APPLICABLE INNDARDS, CONTACT THE UTILITY COMPANY REPRESENTATIVES S.	OR INSTRUMENT  INSTRUMENT OR DEVICE (LOCAL PANEL)  INSTRUMENT OR DEVICE (LOCAL PANEL)  INSTRUMENT OR DEVICE (LOCAL PANEL)  INSTRUMENT OR DEVICE (LAB ROOM PANEL)  INSTRUMENT OR DEVICE (LAB ROOM PANEL)  ISPLAY (LOCAL PANEL)  ISPLAY (LOCATIONS OF PLECTRICAL EQUIPMENT ISPLAY LOCATIONS OF PLECTRICAL EQUIPMENT ISPLAY (LOCATIONS OF PLECTRICAL EQUIPMENT ISPLAY LOCATION SHOWN ON THIS PAGE WILL  MMATIC ONLY; EXACT LOCATIONS OF PLECTRICAL EQUIPMENT ISPLAY REPRESENTATIVES  ISPLAY (LOCATIONS OF ALL APPLICABLE INFORMATION SHOWN REPRESENTATIVES	ATION BUBBLE				97E PARK
INSTRUMENT OR DEVICE (LOCAL PANEL)  INSTRUMENT OR DEVICE (LOCAL PANEL)  INSTRUMENT OR DEVICE (LAB ROOM PANEL)  ISPLAY (LOCAL PANEL)  ISPLAY (LOCAL PANEL)  ISPLAY (LAB ROOM	INSTRUMENT OR DEVICE (LOCAL PANEL)  INSTRUMENT OR DEVICE (LOCAL PANEL)  INSTRUMENT OR DEVICE (LOCAL PANEL)  INSTRUMENT OR DEVICE (LAB ROOM PANEL)  ISPLAY (LOCAL PANEL)  ISPLAY (LOCAL PANEL)  ISPLAY (LAB ROOM PANEL)  ISPLAY (LAB ROOM PANEL)  ISPLAY (LAB ROOM PANEL)  ISPLAY (LAB ROOM PANEL)  ISPLAY (LOCAL PANEL)  ISPLAY (LAB ROOM PANEL)  ISPLAY (	OR INSTRUMENT				
NSTRUMENT OR DEVICE (LOCAL PANEL) INSTRUMENT OR DEVICE (LAB ROOM PANEL) ISPLAY (LOCAL PANEL) ISPLAY (LOCAL PANEL) ISPLAY (LAB ROOM PANEL) ISPLAY (LAB	INSTRUMENT OR DEVICE (LOCAL PANEL) INSTRUMENT OR DEVICE (LOCAL PANEL) INSTRUMENT OR DEVICE (LAB ROOM PANEL) ISPLAY (LOCAL PANEL) ISPLAY (LOCAL PANEL) ISPLAY (LAB ROOM PANEL)					COMMISSION
PANEL)	ISPLAY (LOCAL PANEL) ISPLAY (LAB ROOM PANEL) ELECTRICAL LEGEND IOT ALL OF THE INFORMATION SHOWN ON THIS PAGE WILL MMATIC ONLY; EXACT LOCATIONS OF ELECTRICAL EQUIPMENT ILD BY THE CONTRACTOR. THE INSTALLATION OF ALL AWINGS OR DESCRIBED IN THE SPECIFICATIONS SHALL SET FORTH IN THE LATEST EDITIONS OF ALL APPLICABLE ANDARDS. CONTACT THE UTILITY COMPANY REPRESENTATIVES					
GENERAL NOTES IOT ALL OF THE INFORMATION SHOWN ON THIS PAGE WILL MMATIC ONLY; EXACT LOCATIONS OF ELECTRICAL EQUIPMENT ELD BY THE CONTRACTOR. THE INSTALLATION OF ALL AWINGS OR DESCRIBED IN THE SPECIFICATIONS SHALL S SET FORTH IN THE LATEST EDITIONS OF ALL APPLICABLE ANDARDS. CONTACT THE UTILITY COMPANY REPRESENTATIVES S.	GENERAL NOTES IOT ALL OF THE INFORMATION SHOWN ON THIS PAGE WILL MMATIC ONLY; EXACT LOCATIONS OF ELECTRICAL EQUIPMENT ELD BY THE CONTRACTOR. THE INSTALLATION OF ALL AWINGS OR DESCRIBED IN THE SPECIFICATIONS SHALL S SET FORTH IN THE LATEST EDITIONS OF ALL APPLICABLE ANDARDS. CONTACT THE UTILITY COMPANY REPRESENTATIVES	ISPLAY (LOCAL PANEL)				
GENERAL NOTES NOT ALL OF THE INFORMATION SHOWN ON THIS PAGE WILL MMATIC ONLY; EXACT LOCATIONS OF ELECTRICAL EQUIPMENT ELD BY THE CONTRACTOR. THE INSTALLATION OF ALL AWINGS OR DESCRIBED IN THE SPECIFICATIONS SHALL S SET FORTH IN THE LATEST EDITIONS OF ALL APPLICABLE ANDARDS. CONTACT THE UTILITY COMPANY REPRESENTATIVES S.	GENERAL NOTES NOT ALL OF THE INFORMATION SHOWN ON THIS PAGE WILL MMATIC ONLY; EXACT LOCATIONS OF ELECTRICAL EQUIPMENT ELD BY THE CONTRACTOR. THE INSTALLATION OF ALL AWINGS OR DESCRIBED IN THE SPECIFICATIONS SHALL S SET FORTH IN THE LATEST EDITIONS OF ALL APPLICABLE ANDARDS. CONTACT THE UTILITY COMPANY REPRESENTATIVES	ISPLAY (LAB ROOM PANE	EL)			
GENERAL NOTES NOT ALL OF THE INFORMATION SHOWN ON THIS PAGE WILL MMATIC ONLY; EXACT LOCATIONS OF ELECTRICAL EQUIPMENT ELD BY THE CONTRACTOR. THE INSTALLATION OF ALL AWINGS OR DESCRIBED IN THE SPECIFICATIONS SHALL S SET FORTH IN THE LATEST EDITIONS OF ALL APPLICABLE ANDARDS. CONTACT THE UTILITY COMPANY REPRESENTATIVES S.	GENERAL NOTES NOT ALL OF THE INFORMATION SHOWN ON THIS PAGE WILL MMATIC ONLY; EXACT LOCATIONS OF ELECTRICAL EQUIPMENT ELD BY THE CONTRACTOR. THE INSTALLATION OF ALL AWINGS OR DESCRIBED IN THE SPECIFICATIONS SHALL S SET FORTH IN THE LATEST EDITIONS OF ALL APPLICABLE ANDARDS. CONTACT THE UTILITY COMPANY REPRESENTATIVES				1	ELECTRICAL LEGEND
IOT ALL OF THE INFORMATION SHOWN ON THIS PAGE WILL MMATIC ONLY; EXACT LOCATIONS OF ELECTRICAL EQUIPMENT ELD BY THE CONTRACTOR. THE INSTALLATION OF ALL AWINGS OR DESCRIBED IN THE SPECIFICATIONS SHALL S SET FORTH IN THE LATEST EDITIONS OF ALL APPLICABLE ANDARDS. CONTACT THE UTILITY COMPANY REPRESENTATIVES S.	NOT ALL OF THE INFORMATION SHOWN ON THIS PAGE WILL MMATIC ONLY; EXACT LOCATIONS OF ELECTRICAL EQUIPMENT ELD BY THE CONTRACTOR. THE INSTALLATION OF ALL AWINGS OR DESCRIBED IN THE SPECIFICATIONS SHALL S SET FORTH IN THE LATEST EDITIONS OF ALL APPLICABLE ANDARDS. CONTACT THE UTILITY COMPANY REPRESENTATIVES					
MMATIC ONLY; EXACT LOCATIONS OF ELECTRICAL EQUIPMENT ELD BY THE CONTRACTOR. THE INSTALLATION OF ALL AWINGS OR DESCRIBED IN THE SPECIFICATIONS SHALL 5 SET FORTH IN THE LATEST EDITIONS OF ALL APPLICABLE ANDARDS. CONTACT THE UTILITY COMPANY REPRESENTATIVES S.	MMATIC ONLY; EXACT LOCATIONS OF ELECTRICAL EQUIPMENT ELD BY THE CONTRACTOR. THE INSTALLATION OF ALL AWINGS OR DESCRIBED IN THE SPECIFICATIONS SHALL S SET FORTH IN THE LATEST EDITIONS OF ALL APPLICABLE ANDARDS. CONTACT THE UTILITY COMPANY REPRESENTATIVES					
		ANDARDS. CONTACT THE				
SE DUE TO FIELD CONDITIONS, LACK OF INFORMATION OR TWILL BE MADE FOR CHANGES WHICH HAVE NOT BEEN	ATELY IF CONFLICTS IN EQUIPMENT LOCATIONS ARE	-	EQUIPMENT LOCATIO	DNS ARE		
	SE DUE TO FIELD CONDITIONS, LACK OF INFORMATION OR	SE DUE TO FIELD CONDI	ITIONS, LACK OF INF	ORMATION OR	RH7	
	SHEET 14 OF 20					SHEET 14 OF 20
-						

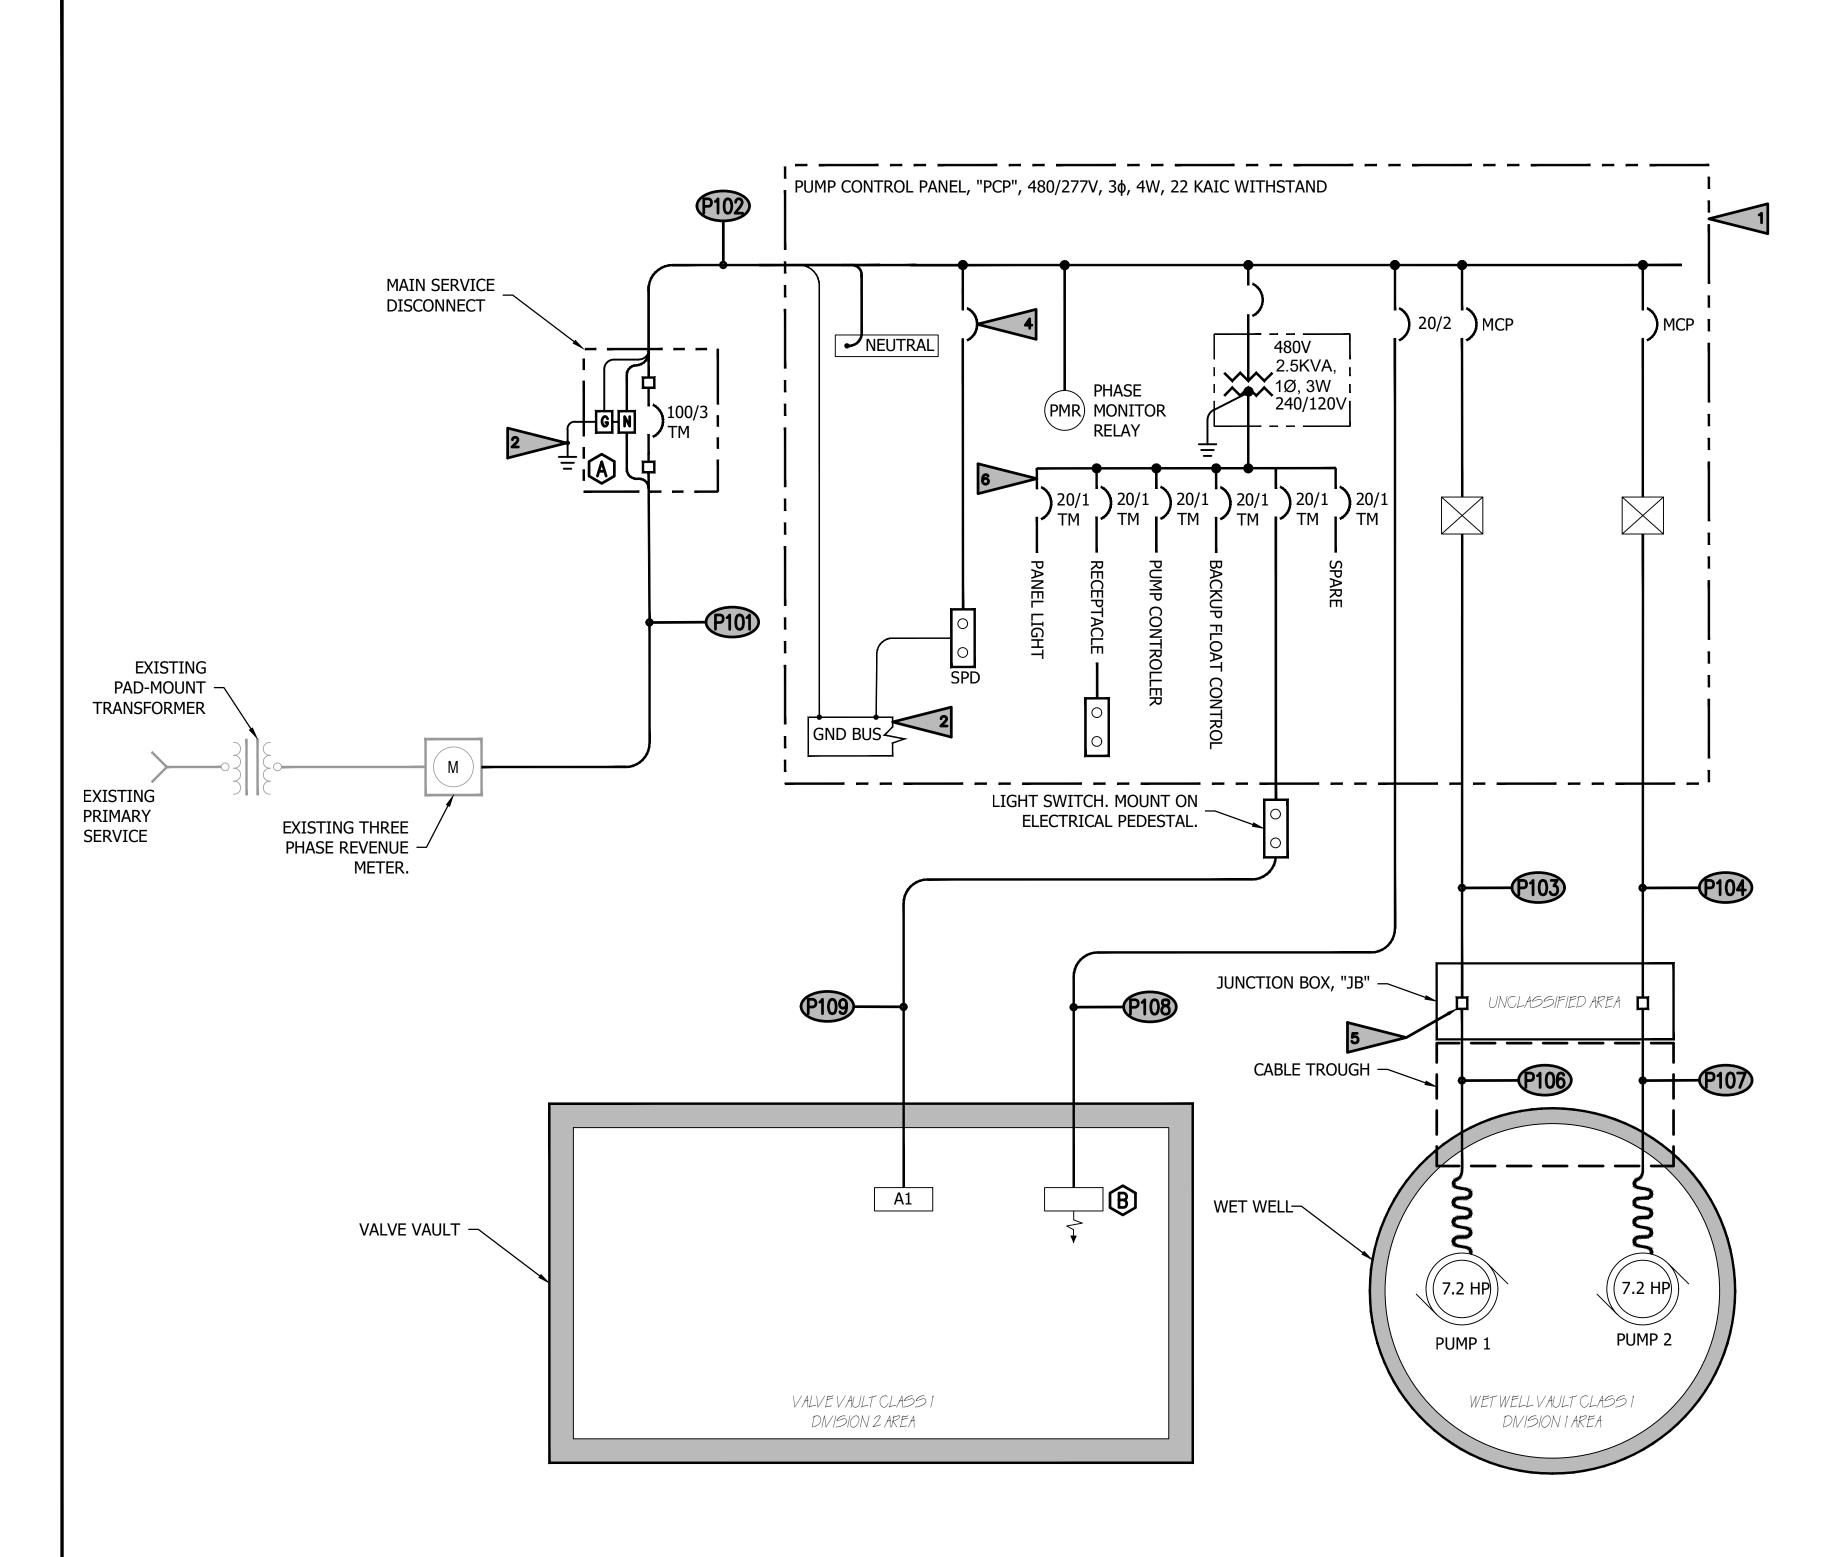

ONE-LINE DIAGRAM NOT TO SCALE

				CAD NO. PSP-D-EC	)2
	ELECTRICAL NOT	ES			
1	1. PUMP CONTROL PANEL TO BE SU SEE SHEET NO. 17 FOR TYPICAL PU DIAGRAMS. ONE-LINE AND CONTRO OPTIONS THAT SHALL BE PROVIDED	MP CONTROL LOG L DIAGRAMS SHO	SIC		
2	2. SEE GROUNDING DETAIL, THIS S	HEET.			
3	3. GROUND ROD PER N.E.C. (TYPICA DETAIL.	AL). SEE SHEET N	io. 19 for		
	4. FUSING OR CIRCUIT BREAKER PE RECOMMENDATION. USE SHORTEST SPD.				
5	5. TERMINAL BLOCKS (TYPICAL). SE	E SHEET NO. 19 F	OR DETAIL.		
	6. PROVIDE LED MOTION SENSOR P INSIDE CEILING.	ANEL LIGHT. MOU	JNT TO		
	7. SEE ELECTRICAL SITE PLAN FOR BE INSTALLED IN WET WELL.	OTHER CONTROL	DEVICES TO		BY         DA ⁻ CCA         1/27/2
XX	8. SEE SHEET NO. 20 FOR CONDUIT	AND CONDUCTO	R SCHEDULE.	CHECKED (FIELD	CLC 1/27/2
$\bigotimes$	9. SEE SHEET NO. 20 FOR ELECTRIC	AL EQUIPMENT S	CHEDULE.	CHECKED (HDQT	S.)
A#	10. SEE SHEET NO. 20 FOR LIGHTIN	g fixture schei	DULE.		
	PUMP STATION LOAD CALCUL	ATIONS			
2 HP)		11.0A X 1.25 =	13.75 AMPS		ON C. AND
, .2 HP)		11.0A X 1.00 =	11.0 AMPS	J.	ST OF WASHING
.800 W	()	6.5A X 1.00 =	6.50 AMPS		, 54353
NEOUS	(2.25 KVA)	5.2A X 1.00 =	5.2 AMPS		PEGISTERED HUS
			36.45 AMPS		D: 01/27/2025
				WASHI	NGTON
				STATE	WASHINGTON
				PARKS	
					STAT BRING
				RECRE	ATION
				COMMI	.9910IN
				POTHOL	ES
	SERVICE ENTRANCE			STATE P	
	S/N (SOLID NEUTRAL)				
				SEWER LIF REPLACEM	T STATION ENT
•	GROUND BUS				
	#8			ONE-LINE	DIAGRAM
プ	¢		_		
		_ EQUIPMENT PA	ND .		
		REBAR MAT			

				CA	ad No
	ELECTRICAL NOT	ES			
	1. PUMP CONTROL PANEL TO BE SUP SEE SHEET NO. 17 FOR TYPICAL PUN DIAGRAMS. ONE-LINE AND CONTROL OPTIONS THAT SHALL BE PROVIDED	MP CONTROL LOG L DIAGRAMS SHO	SIC		
2	2. SEE GROUNDING DETAIL, THIS SH	IEET.			
3	3. GROUND ROD PER N.E.C. (TYPICA DETAIL.	L). SEE SHEET N	IO. 19 FOR		
4	4. FUSING OR CIRCUIT BREAKER PER RECOMMENDATION. USE SHORTEST SPD.				
5	5. TERMINAL BLOCKS (TYPICAL). SEI	E SHEET NO. 19 F	FOR DETAIL.		
6	6. PROVIDE LED MOTION SENSOR PAINSIDE CEILING.	ANEL LIGHT. MOU	JNT TO	$\vdash$	
	7. SEE ELECTRICAL SITE PLAN FOR ( BE INSTALLED IN WET WELL.	OTHER CONTROL	DEVICES TO		
XX	8. SEE SHEET NO. 20 FOR CONDUIT	AND CONDUCTO	R SCHEDULE.		CHECK
$\bigotimes$	9. SEE SHEET NO. 20 FOR ELECTRIC	AL EQUIPMENT S	CHEDULE.		
A#	10. SEE SHEET NO. 20 FOR LIGHTING	g fixture schei	DULE.		
2 1 (7.2 HP)	PUMP STATION LOAD CALCUL	ATIONS 11.0A X 1.25 =	13.75 AMPS		
2 (7.2 HP)		11.0A X 1.00 =	11.0 AMPS		
ER (1800 W	)	6.5A X 1.00 =	6.50 AMPS		
ELLANEOUS	(2.25 KVA)	5.2A X 1.00 =	5.2 AMPS		
L			36.45 AMPS		
				•	W.
					ST
				]	PA
				]	RE
					CC
	SERVICE ENTRANCE			F	PO
	DISCONNECT SWITCH				ST
	S/N (SOLID NEUTRAL)				SEV REP
	• GROUND BUS •				ONE
<b>←</b>	•				

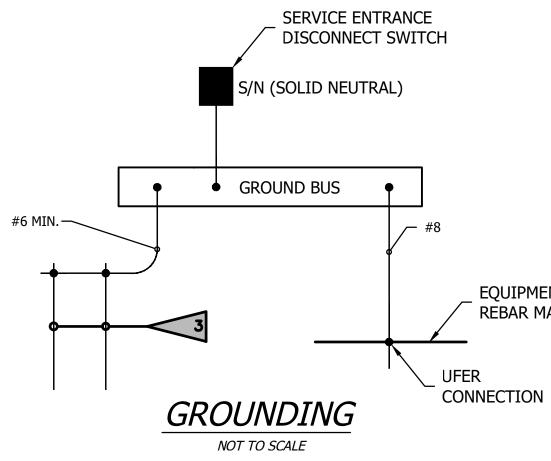

UFER





SHEET 15 OF 20

DATE

CCA 1/27/2025


CLC 1/27/2025

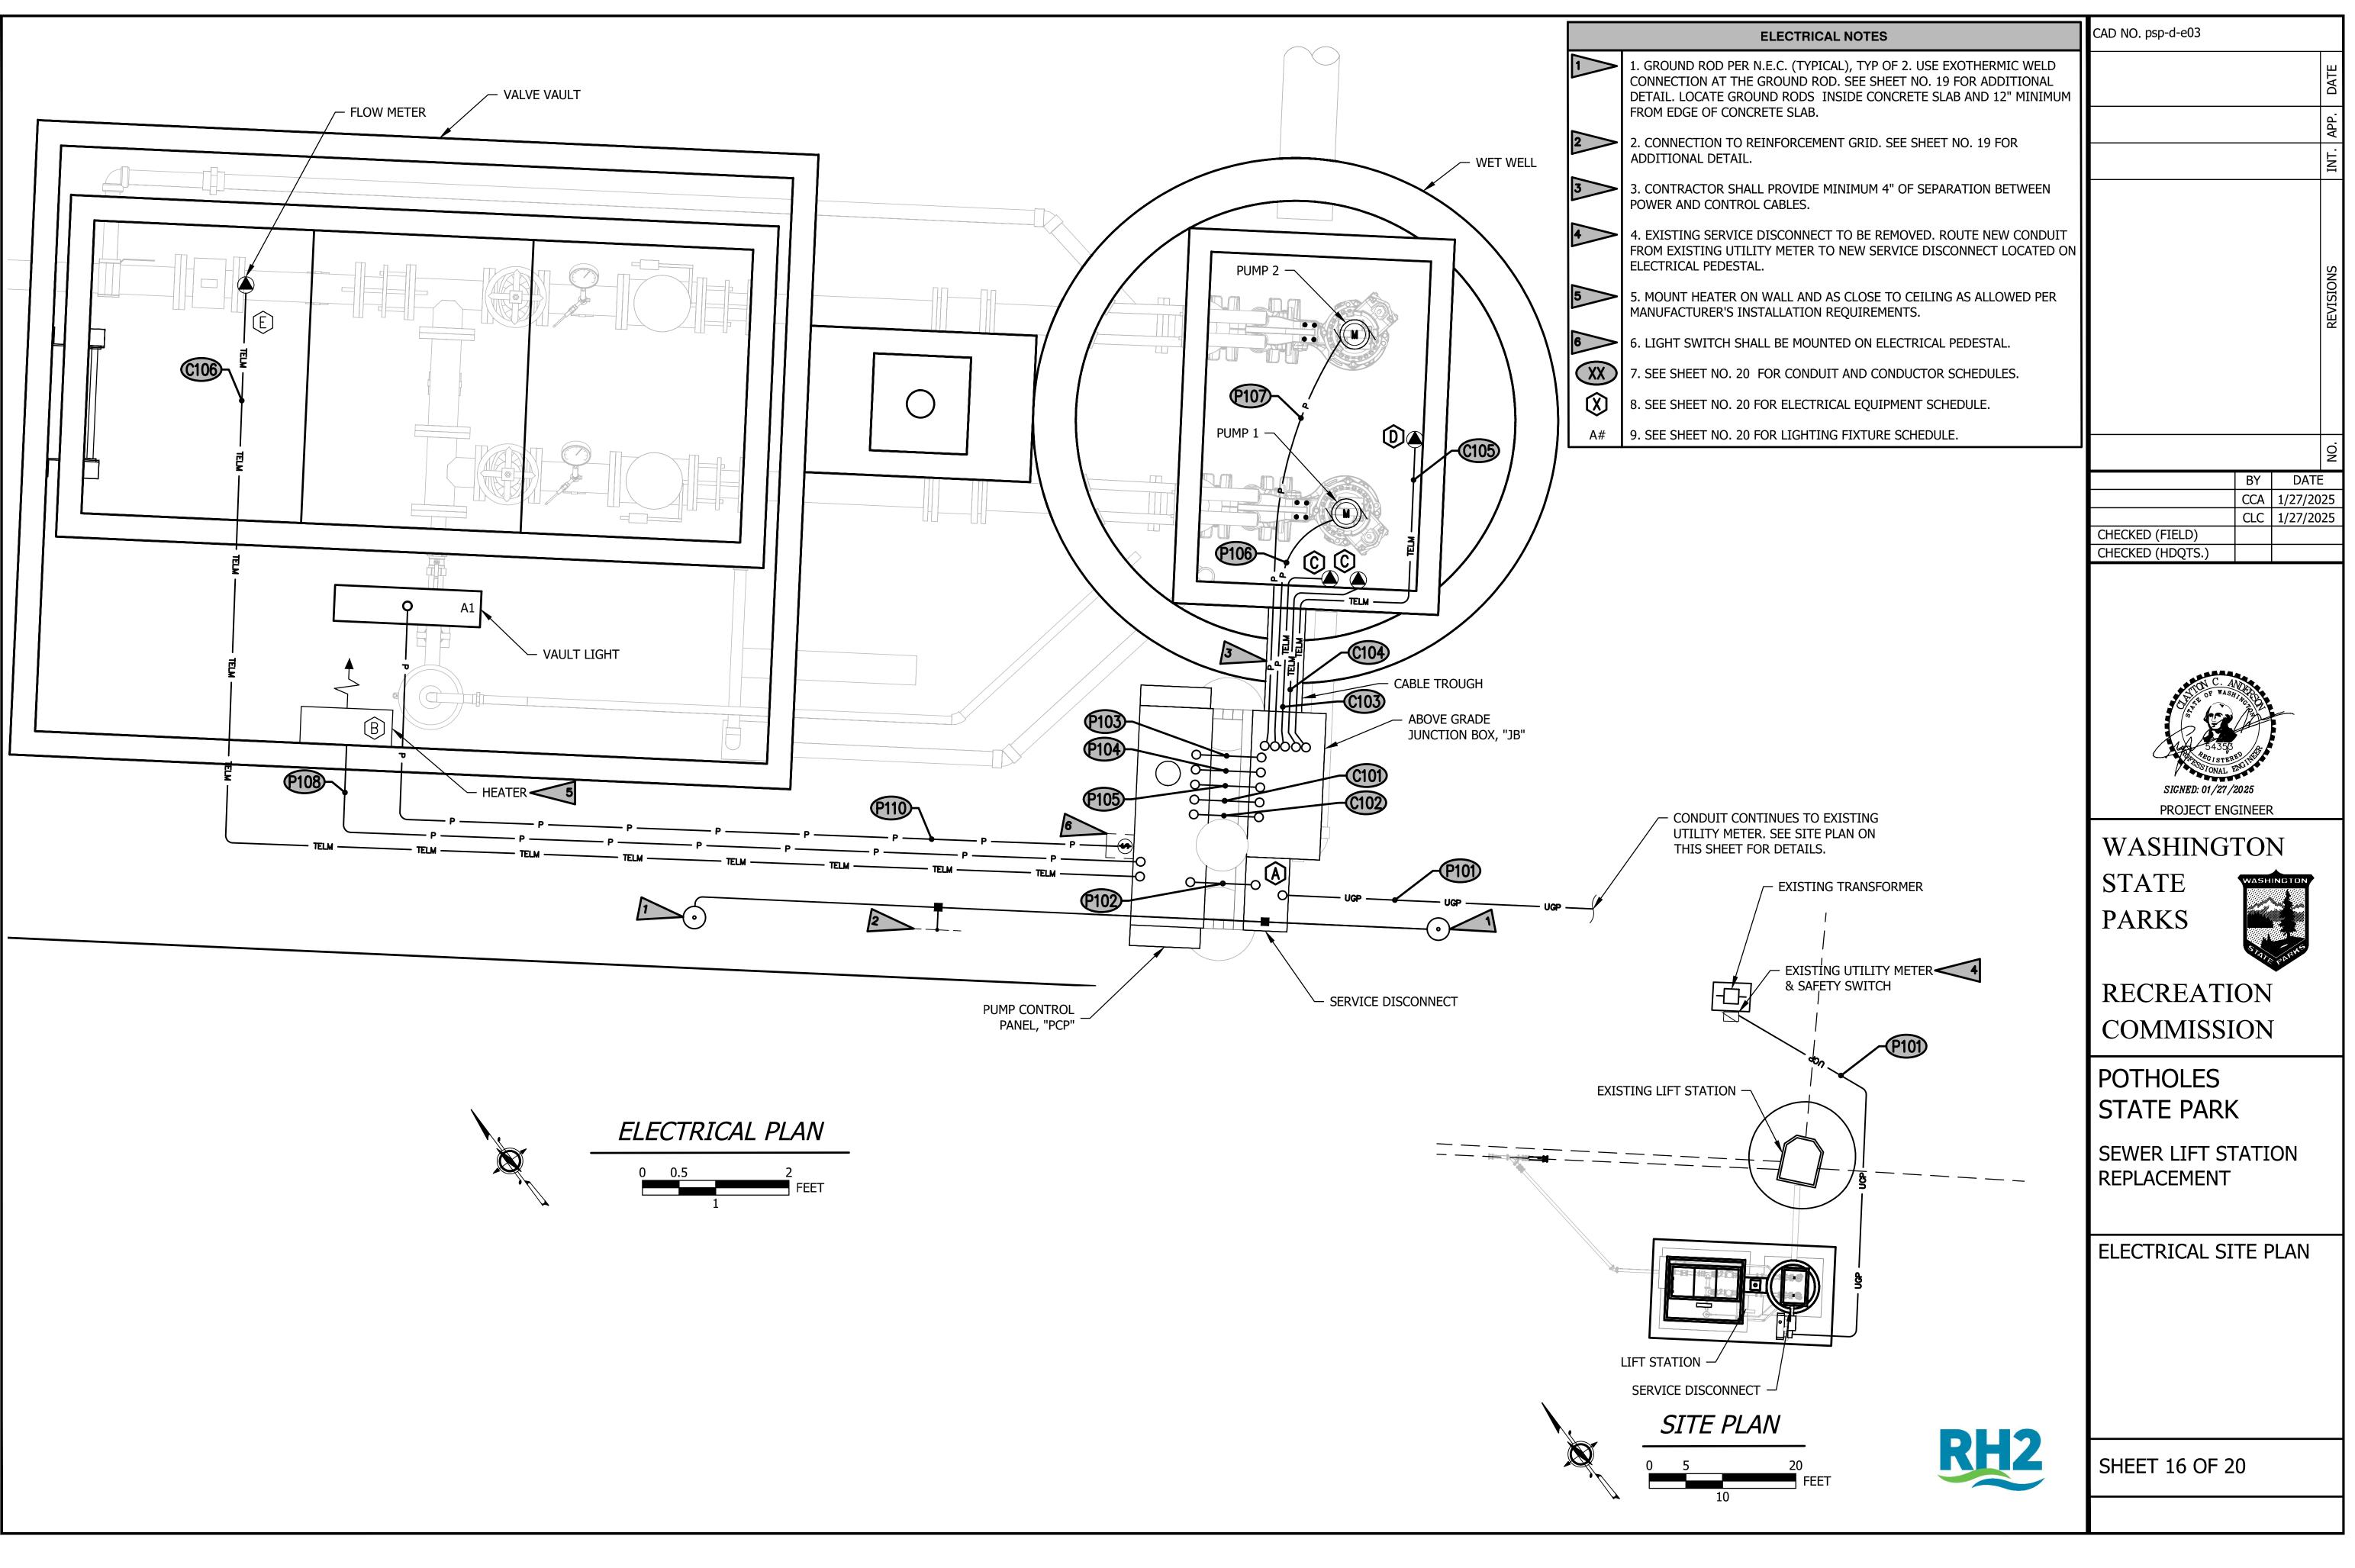

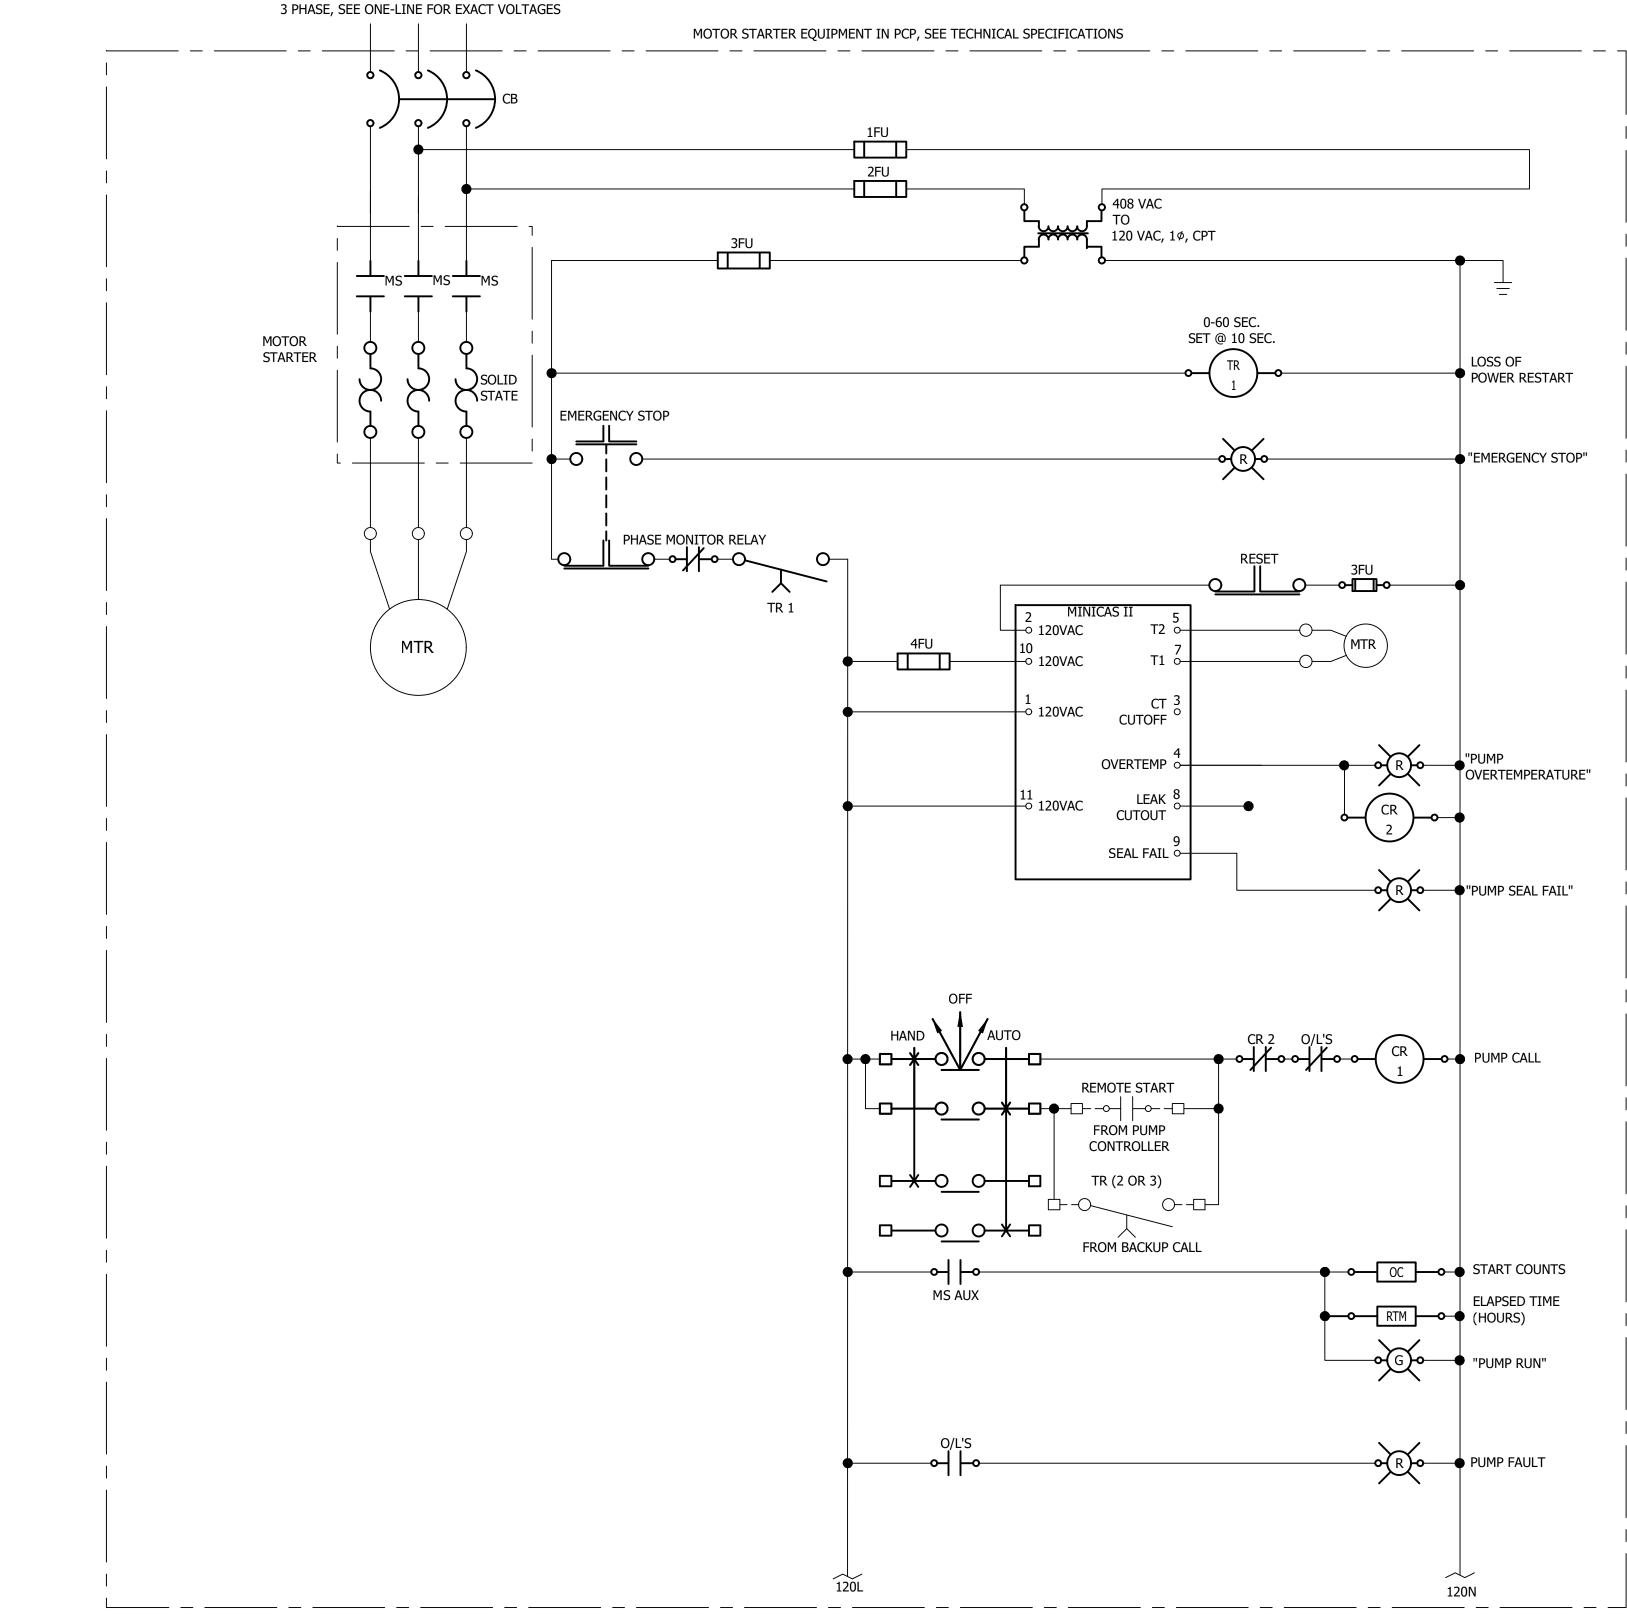





NO SCALE

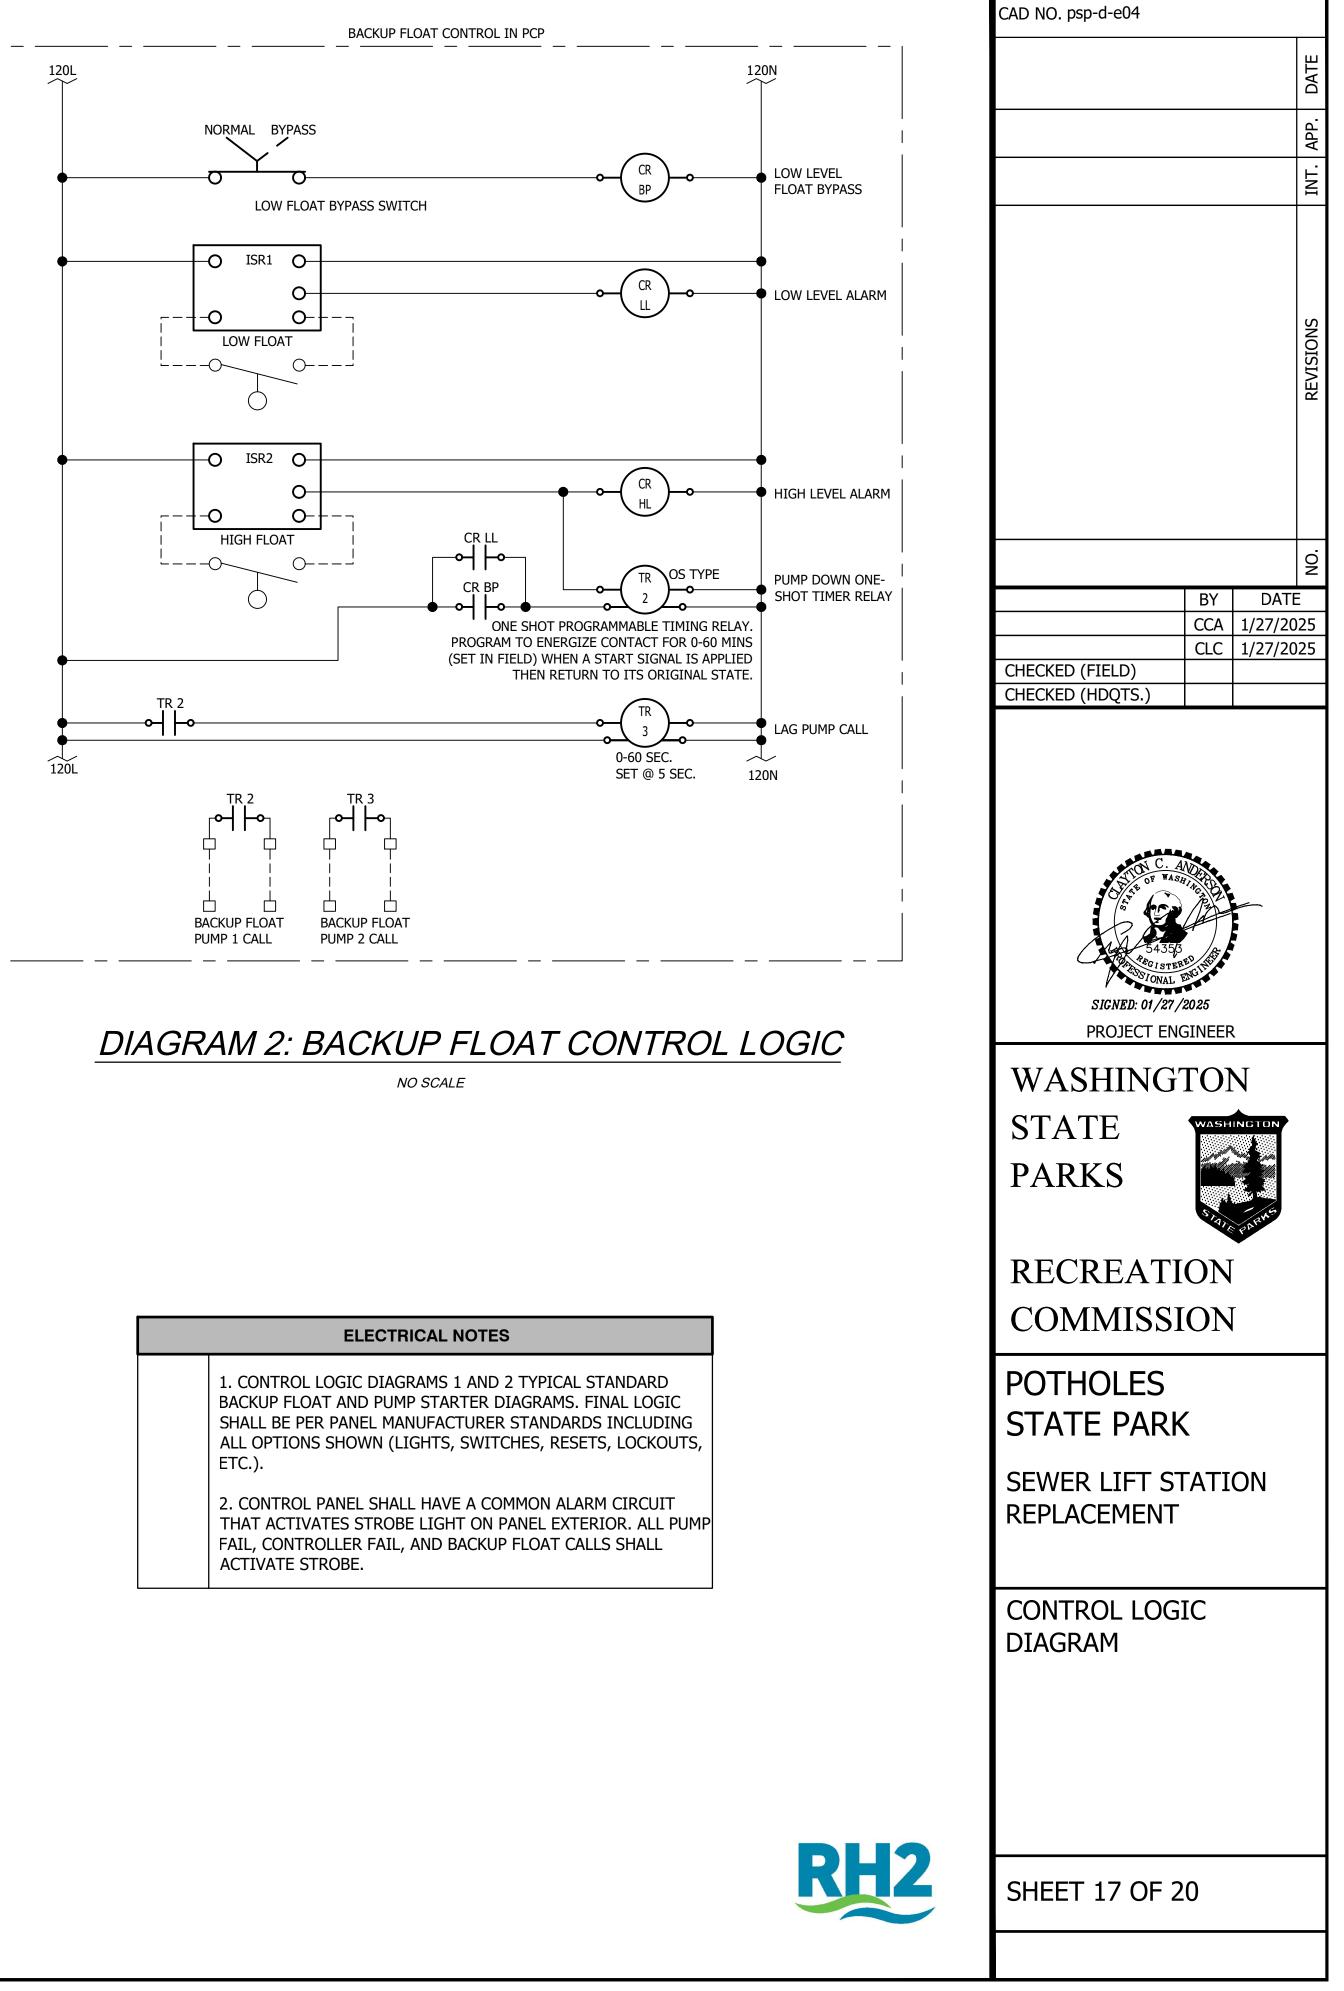

ELECTRICAL NOTES
1. CONTROL LOGIC DIAGRAMS 1 AND 2 TYPIC/ BACKUP FLOAT AND PUMP STARTER DIAGRAM SHALL BE PER PANEL MANUFACTURER STAND/ ALL OPTIONS SHOWN (LIGHTS, SWITCHES, RE ETC.).
2. CONTROL PANEL SHALL HAVE A COMMON A THAT ACTIVATES STROBE LIGHT ON PANEL EX FAIL, CONTROLLER FAIL, AND BACKUP FLOAT ACTIVATE STROBE.

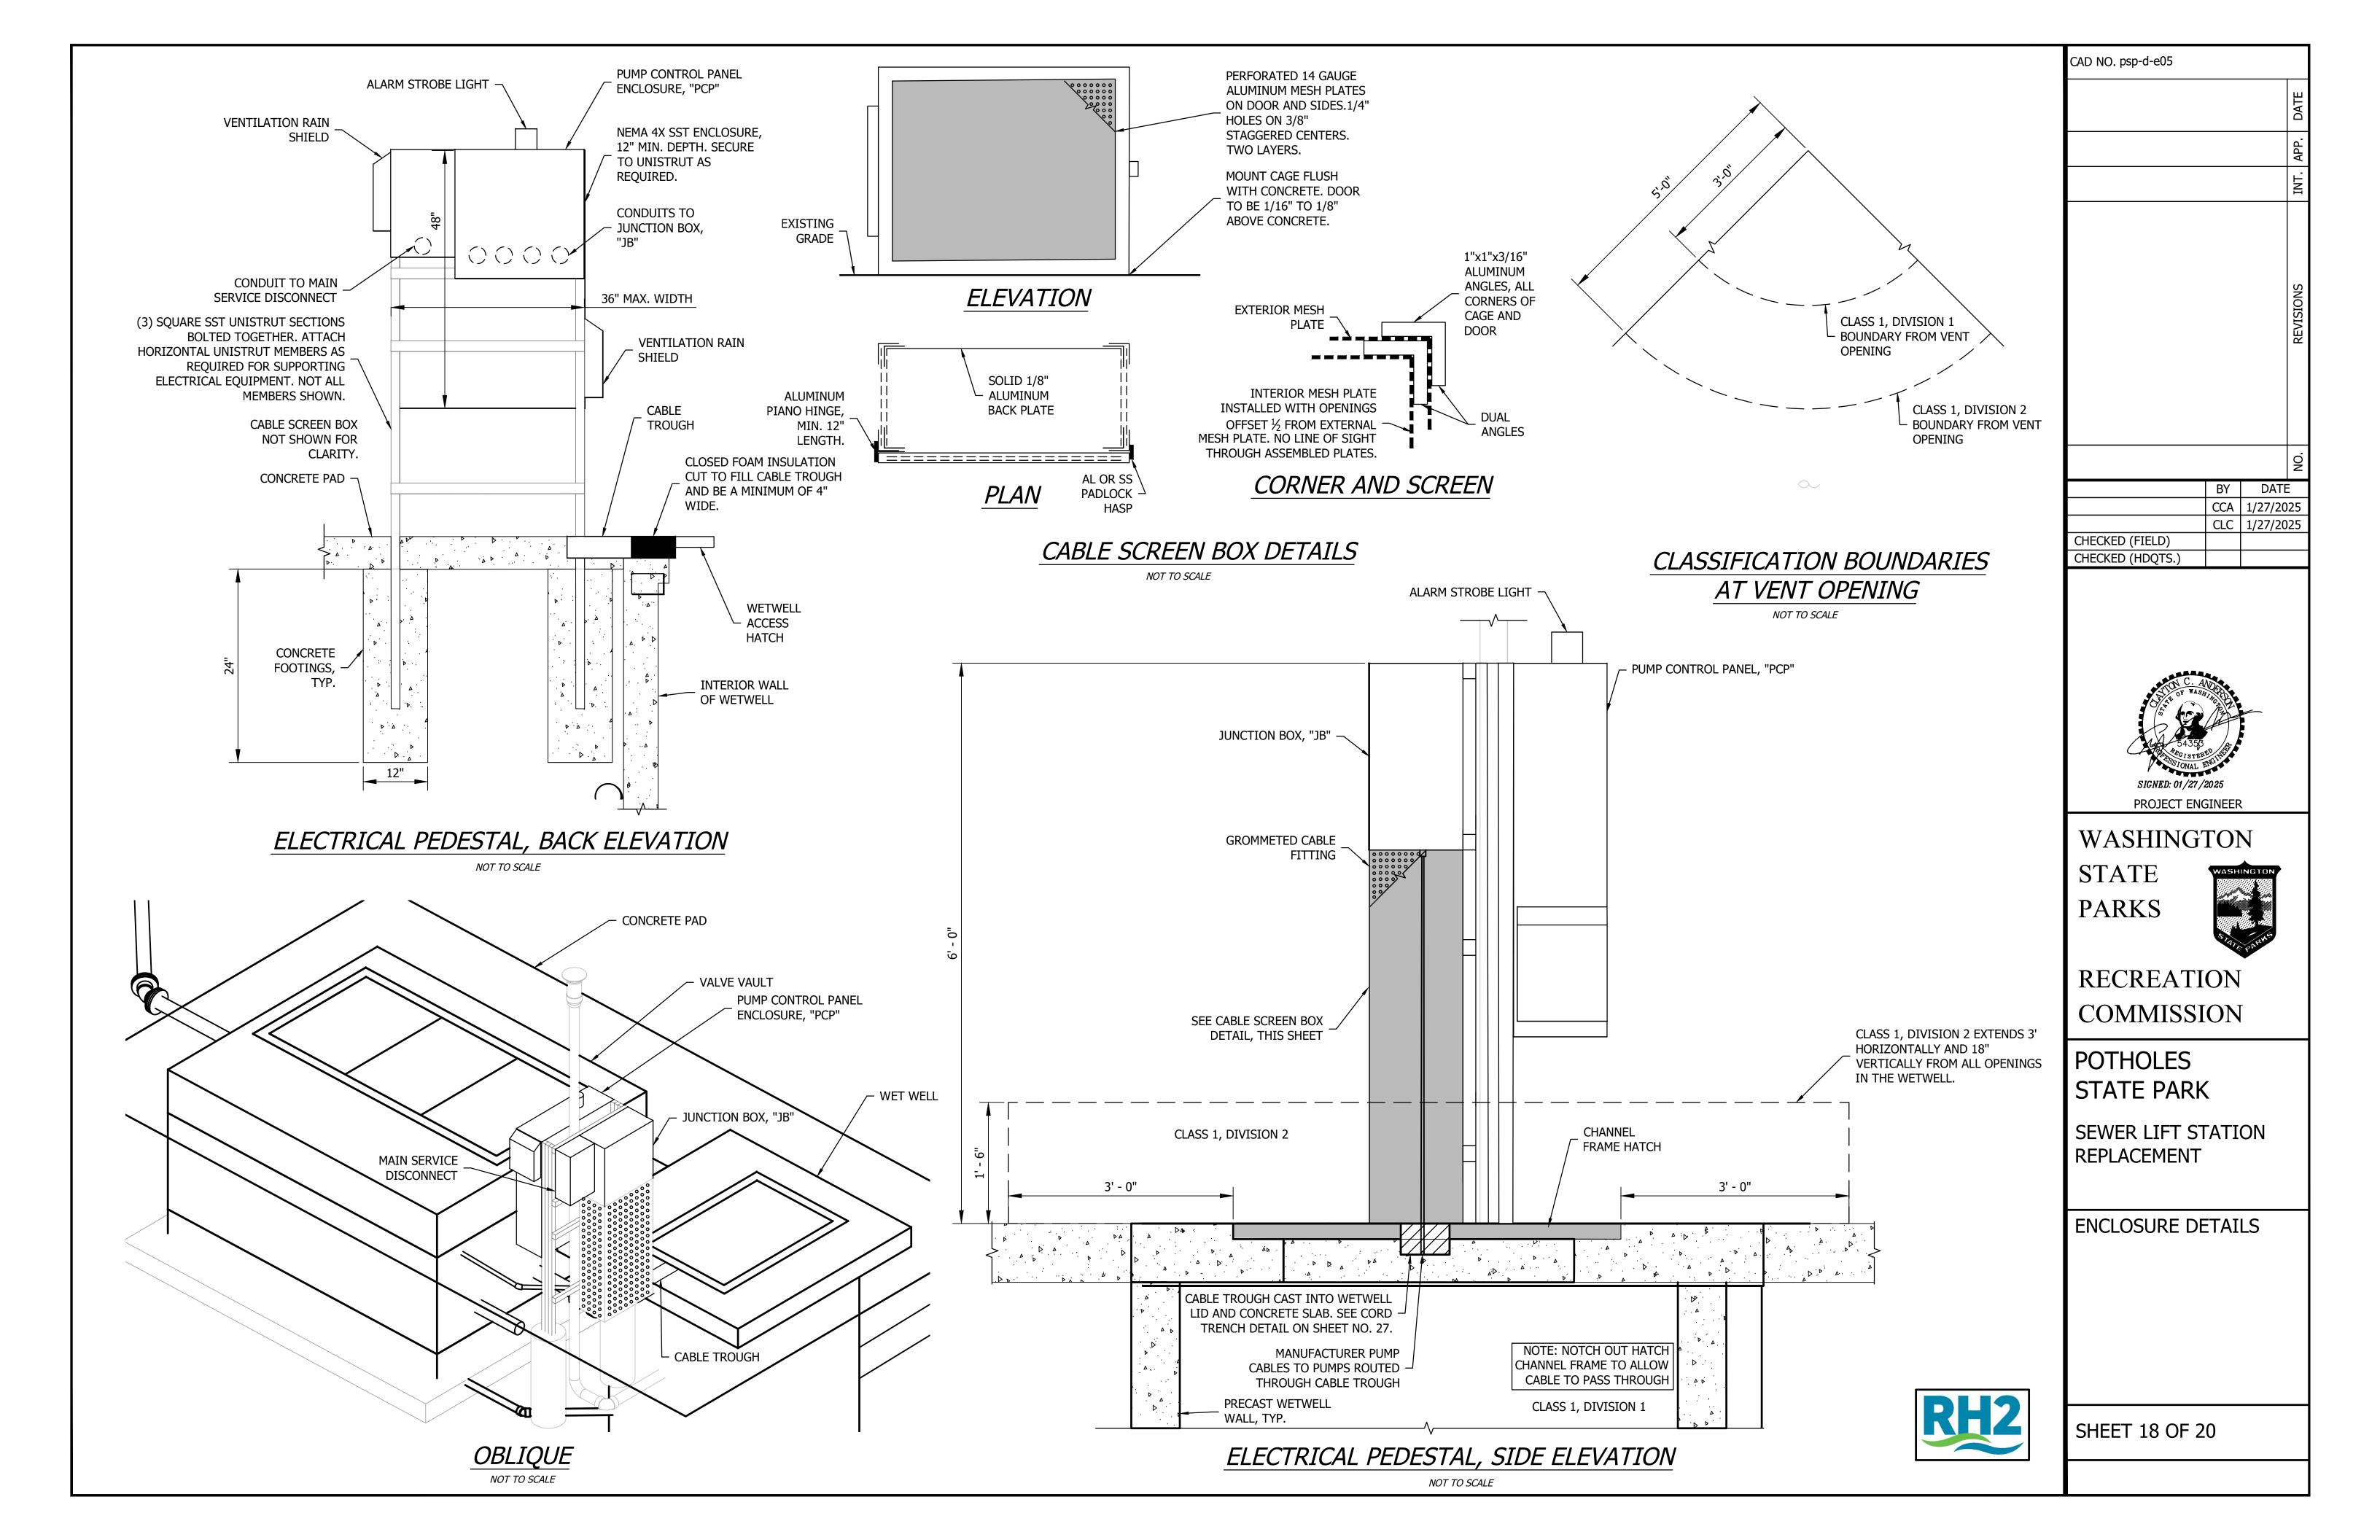


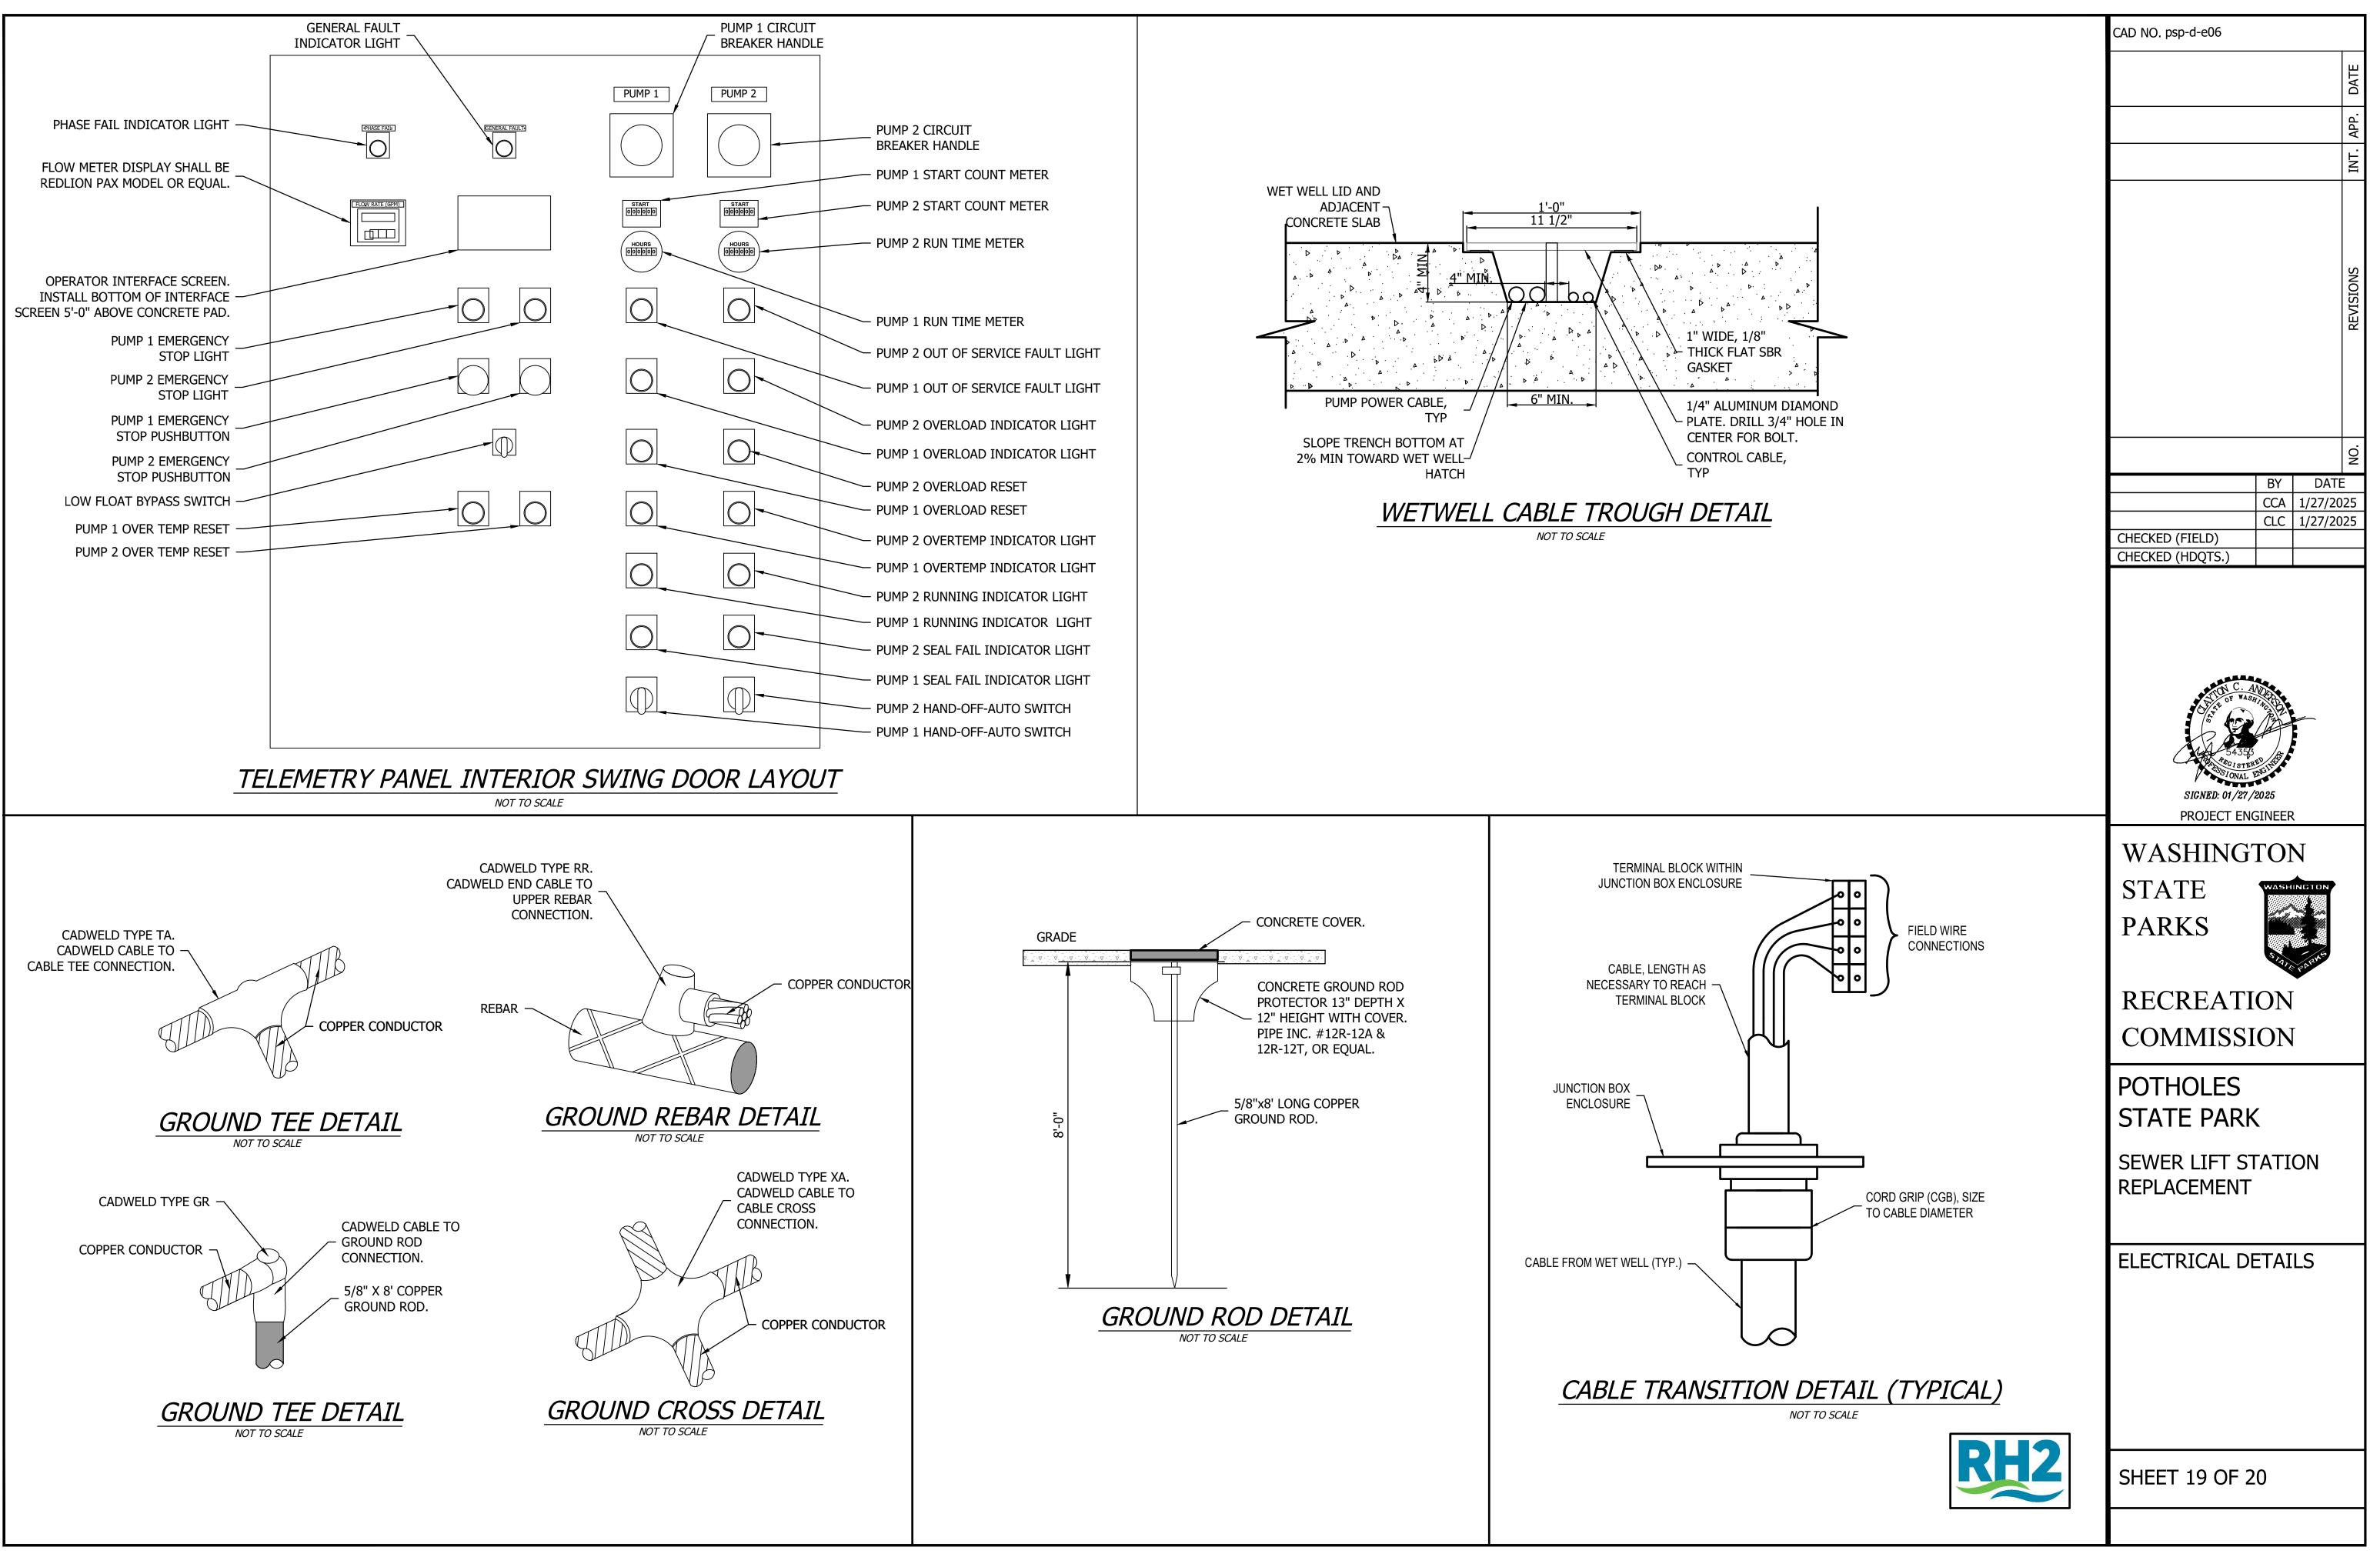

	POWER CONDUIT AND CONDUCTOR SCHEDULE						
CIRCUIT	SOURCE	DESTINATION	TRADE SIZE	(QUANTITY) CONDUCTORS	NOTES		
P101	EXISTING UTILITY METER	MAIN SERVICE DISCONNECT	1 1/4"	(3) – #3, (1) – #3 NEUTRAL			
P102	MAIN SERVICE DISCONNECT	PUMP CONTROL PANEL, "PCP"	1 1/4"	(3) – #3, (1) – #3 NEUTRAL, (1) – #8 GND			
P103	PUMP CONTROL PANEL, "PCP"	JUNCTION BOX, "JB"	3/4"	(3) – #12, (1) –#12 GND	PUMP POWER		
P104	PUMP CONTROL PANEL, "PCP"	JUNCTION BOX, "JB"	3/4"	(3) – #12, (1) –#12 GND	PUMP POWER		
P105	PUMP CONTROL PANEL, "PCP"	JUNCTION BOX, "JB"	3/4"	(6) – #14, (1) –#14 GND	PUMP SEAL FAILURE/OVERTEMP ALARM		
P106	JUNCTION BOX, "JB"	PUMP 1	-	MANUFACTURER CABLE	IN CABLE TRENCH		
P107	JUNCTION BOX, "JB"	PUMP 2	-	MANUFACTURER CABLE	IN CABLE TRENCH		
P108	PUMP CONTROL PANEL, "PCP"	VALVE VAULT HEATER	3/4"	(2) – #12, (1) –#12 GND			
P109	PUMP CONTROL PANEL, "PCP"	VALVE VAULT LIGHT SWITCH	3/4"	(2) – #12, (1) –#12 GND			
P110	VALVE VAULT LIGHT SWITCH	VALVE VAULT LIGHT	3/4"	(2) – #12, (1) –#12 GND			

	CONTROL CONDUIT AND CONDUCTOR SCHEDULE						
CIRCUIT	SOURCE	DESTINATION	TRADE SIZE	(QUANTITY) CONDUCTORS			
C101	PUMP CONTROL PANEL, "PCP"	JUNCTION BOX, "JB"	3/4"	(4) — #14, (1) — #14 GND			
C102	PUMP CONTROL PANEL, "PCP"	JUNCTION BOX, "JB"	3/4"	(1) SHIELDED TWISTED PAIR			
C103	JUNCTION BOX, "JB"	WET WELL HIGH LEVEL FLOAT	-	MANUFACTURER CABLE			
C104	JUNCTION BOX, "JB"	WET WELL LOW LEVEL FLOAT	-	MANUFACTURER CABLE			
C105	JUNCTION BOX, "JB"	WET WELL LEVEL TRANSDUCER	-	MANUFACTURER CABLE			
C106	PUMP CONTROL PANEL, "PCP"	VALVE VAULT FLOW METER	1"	(4) – #14, (1) – #14 GND, (1) SHIELDED TWISTED PAIR			


	LIGHTING FIXTURE SCHEDULE						
TYPE	DESCRIPTION	MANUFACTURER	MODEL NO.	LAMP QTY.*			
A1	LED LIGHT FIXTURE – 120VAC, 2' LONG, 47 WATT, 5000K COLOR TEMPERATURE, DIFFUSED OPAL UV-STABILIZED POLYCARBONATE VANDAL RESISTANT LENS, PLATINUM COLOR. CLASS 1, DIVISION 2 EXPLOSION PROOF HAZARDOUS LOCATION RATED.	FME LIGHTING OR EQUAL	TSWXP24 4LVCDP	1			

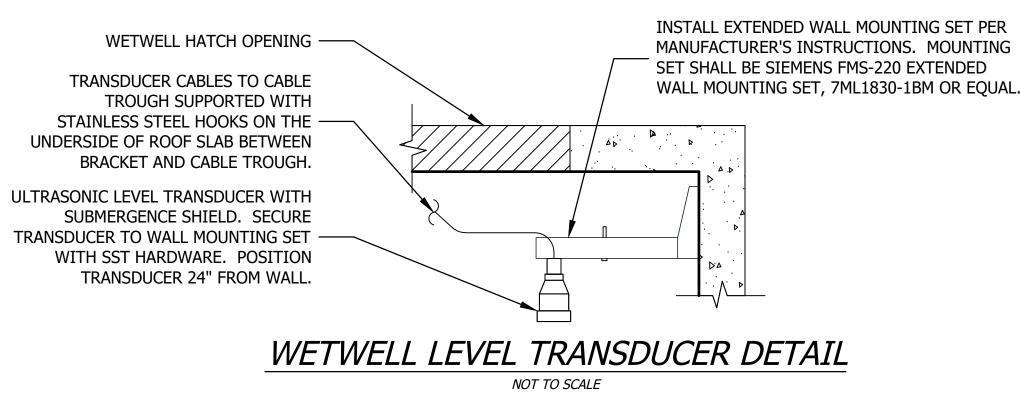

TYPICAL NOTE FOR WETWELL HIGH FLOAT AND PUMP ON LEVELS MAY BE ADJUSTED ONCE ACCURATE INVERT

ELEVATIONS OF INCOMING PIPES HAVE BEEN ESTABLISHED. CONTRACTOR TO LEAVE 4' OF EXTRA CABLE FOR ADJUSTMENT.

	ELECTRICAL EQUIPMENT AND INSTRUMENTATION SCH					
ITEM	DESCRIPTION	MANUFACTURER				
A	SERVICE DISCONNECT, 600V, 25 KAIC, SERVICE ENTRANCE RATED, NEMA 3R, PAD-LOCKABLE	SQUARE D				
₿	EXPLOSION-PROOF HEATER, 1 PHASE, 1800 WATT, 277V. WALL MOUNT HARDWARE, BUILT-IN THERMOSTAT	QMARK				
Ĉ	WET WELL LEVEL FLOAT SWITCH	SEE SPECIFICATIONS				
$\bigcirc$	ULTRASONIC TRANSDUCER LEVEL TRANSMITTER	SEE SPECIFICATIONS				
Ê	FLOW METER	SEE SPECIFICATIONS				

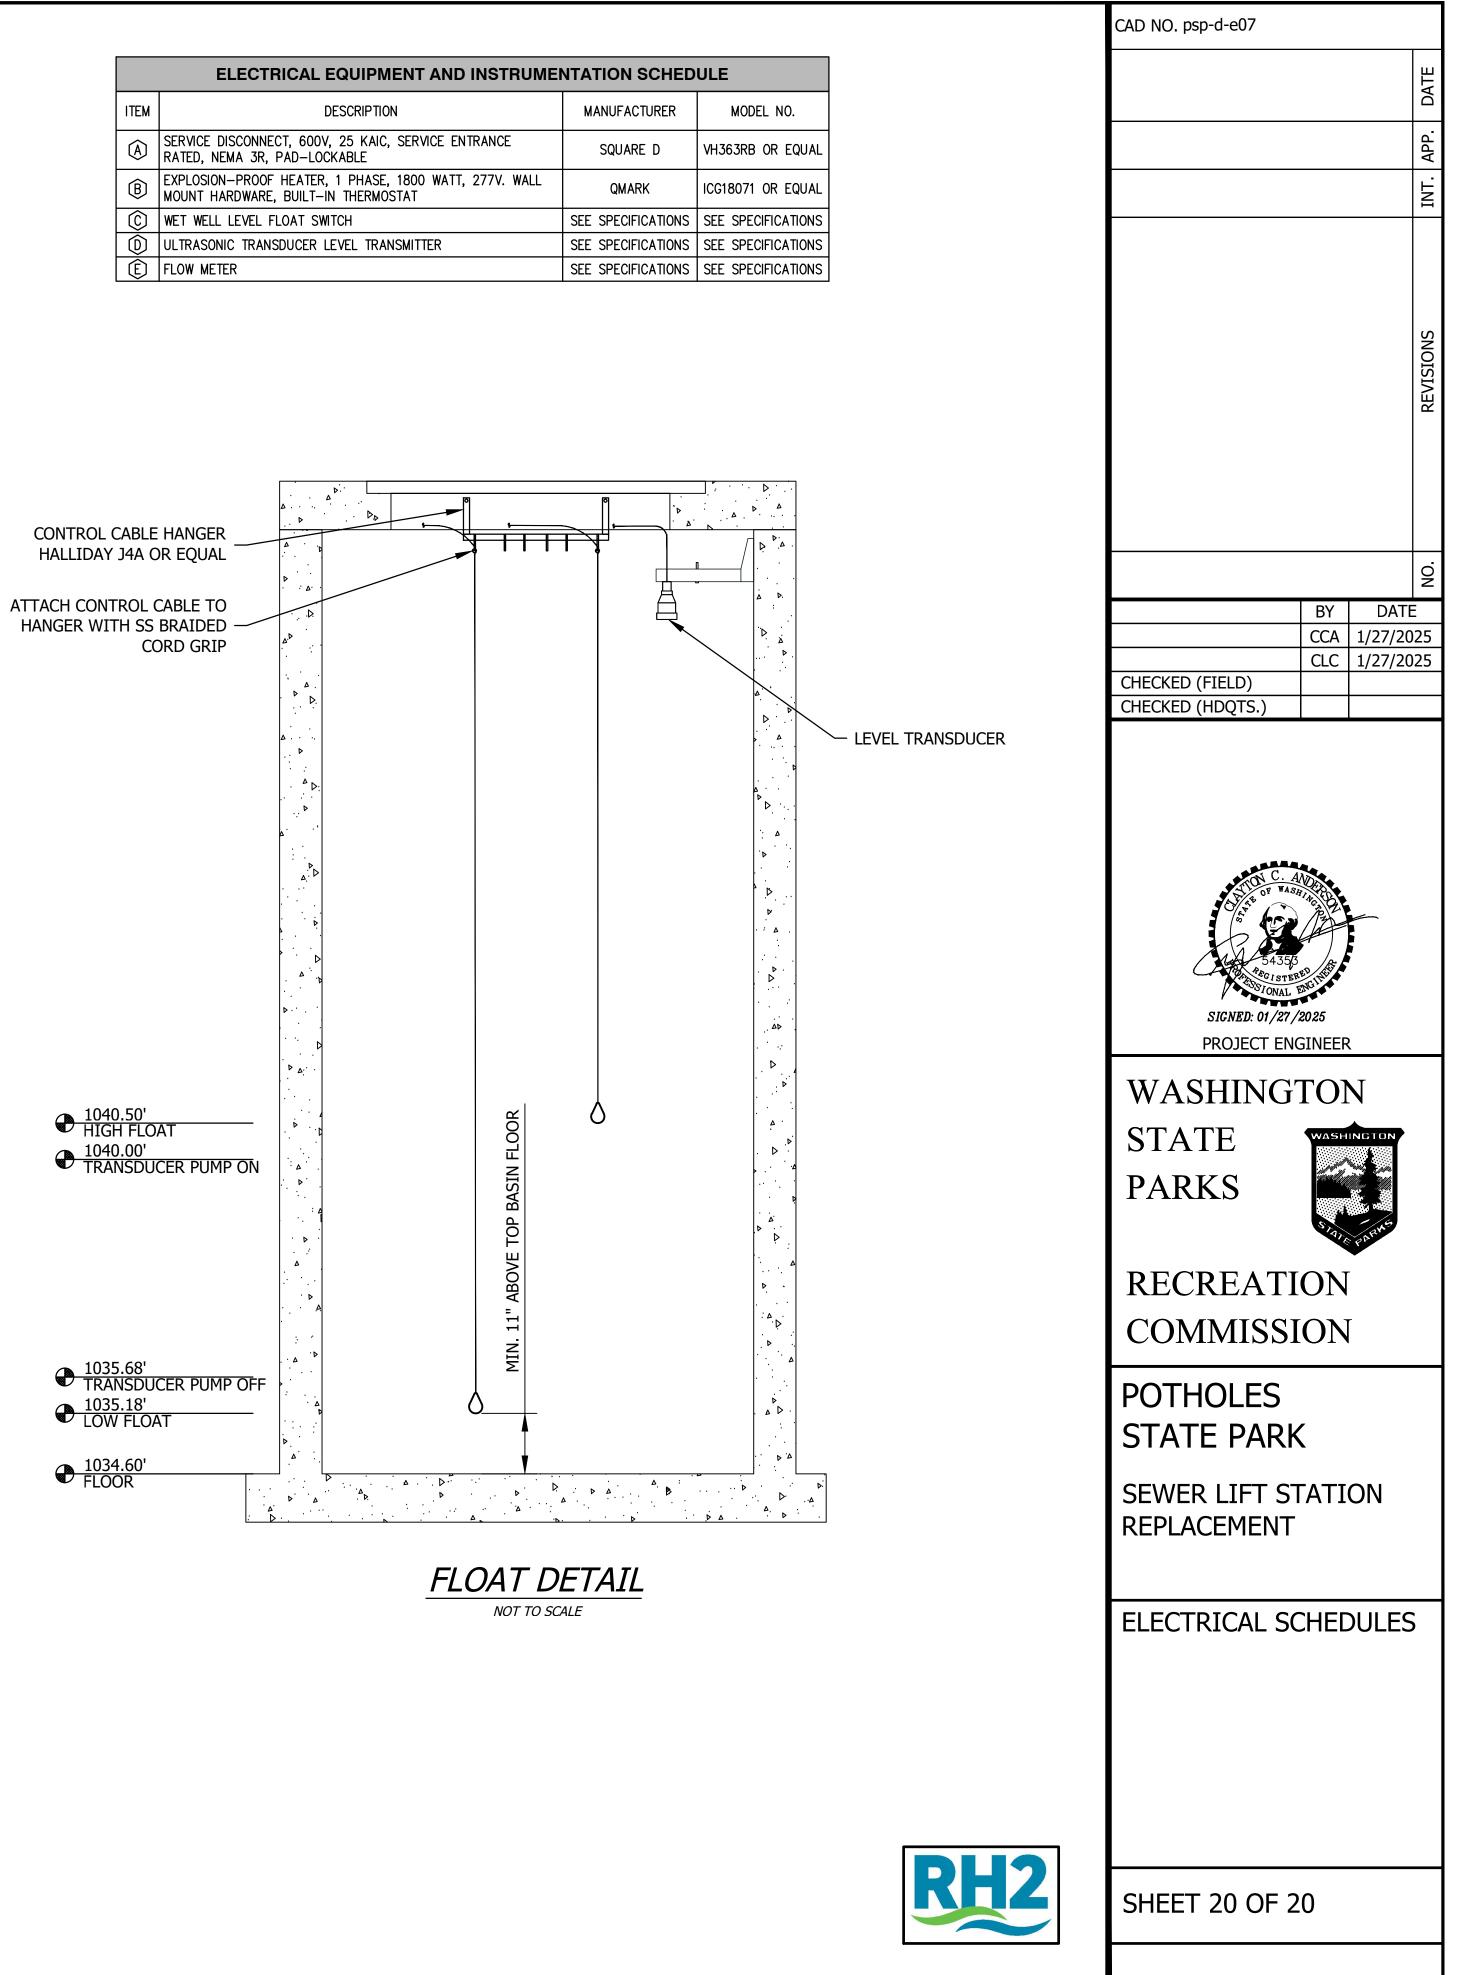

LAMP CATALOG NO

47 WATT

NOTES

IN CABLE TROUGH

IN CABLE TROUGH

IN CABLE TROUGH